

KANSAS


Stafford County

FORM 51 5M PETROL

Section 12 Township 23 Range 12W

Well No. 2 Vivin

Company Phillips

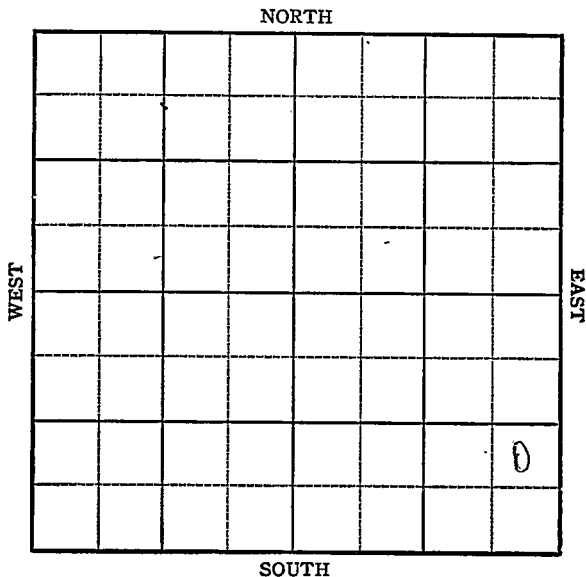


Sec. 12 Twp. 23 R. 12W

Well No. 2 Vivin Farm

Phillips Company

Brock

NORTH

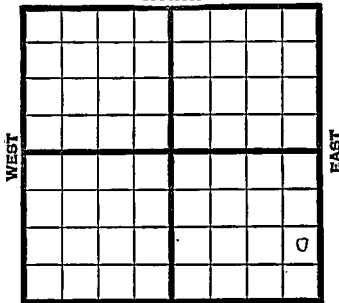

Ft. from N. Line

990 Ft. from S. Line

330 Ft. from E. Line

Ft. from W. Line

NE SE SE Elev. 1836

SOUTH

1945

REPORT

- 5/23 Location
- 5/31 "
- 6/8 RUR
- 6/14 8" @ 401
Drlg. 1700
Lams 3305
Drlg. 3535
- 6/21 Viola 3590
Simp 3630
Arb 3693-95 TD Sat.
5" @ 3693 RUST
- 7/3 TD 3698
500 acid. 1000' oil
- 7/11 Swb 15 oil per hr. 2 hrs
- 7/19 " " " " " "
- 7/23 Arb. 3693
5" @ 3693
500 acid.
TD 3698
Pump 447 Pot.
Grav. 40.0

COMPLETED

Pool Name Brock

Kansas

Map No. 47 Sec. 12 Twp. 23 R. 12^WWell No. 2 VivinPhillips CompanyFIRST REPORT Contractor

NE SE SE

SECTION PLAT

 Ft. from N. Line990 Ft. from S. Line330 Ft. from E. Line Ft. from W. Line

			⊙

Stafford

Location XRig up

Drilling and Remarks:



RECORD

Cased in., ft.Sand Gas Oil Total Depth

PRODUCTION

1st 24 hrs. Nat. 1st 24 hrs. after shot Gas Cu. Ft.Dry Hole Abandoned

Date

MAY 23 1945 19S. J. LEWIS Scout

