

Section 12 Township 23 Range 12WWell No. #3 BrockCompany Beardmore Drlg.

NORTH

WEST

EAST

SOUTH

Stafford

KANSAS

Sec. 12 Twp. 23 R. 12 W ✓Well No. # ³13 Brook Farm

Beardmore Drlg. Company

Contractor

Brock Pool

990 Ft. from N. Line


Ft. from S. Line

990 Ft. from E. Line

Ft. from W. Line

SW NE SE

Phillips farmout

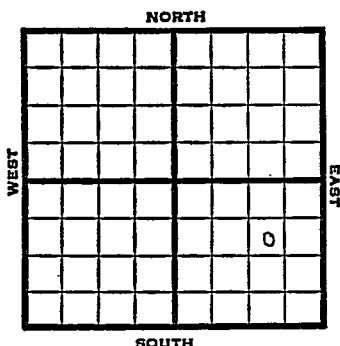

1951

Elev. 1830'

REPORT

8/29

Spud 8-19-51

8" @ 402' Anhy 585'

Drlg. 2518'

9/5

D&A TD 3725'

Spud 8-19-51

8" @ 402

Anhy 585 Br. lime 3287 KC 3317

Viola 3610 Simp. 3657 Abr. 3719


DST 3719-25 open 1 hr. rec. 165'

SW TD 3725

D&A

ABANDONED

County Stafford State Kansas
 Sec. 12 (Blk.) 23 (Sur.) 12W Map No.
 (Twp.) (Rge.)
 Operator Beardmore Drig.
 Well No. 3 ~~X~~ Farm Brock
 Elev. Location SW NE SE

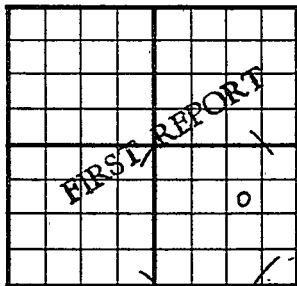

990 Ft. From N Line SE
990 Ft. From E Line Quarter
 1st. Report AUG 29 1951

Completion

Remarks Phillips farmout

See Correction

Spudding Date 8-19-51

Drig. Data

Brock Pool

8" @ 402 Anhy 585 drlg. 2518

J. E. TYRA

Map No. _____ Sec. 12 Twp. 23 R. 12WWell No. 3 Brock

Beardmore Drlg. _____ Company

~~CORRECTION~~ _____ Contractor

SW NE SE


SECTION PLAT

990 Ft. from N. Line

_____ Ft. from S. Line

990 Ft. from E. Line

_____ Ft. from W. Line

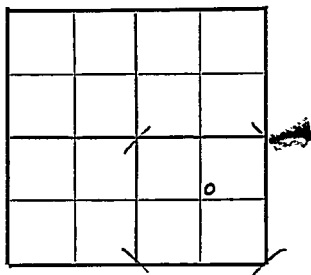

Stafford County

Location _____

Rig up _____

Drilling and Remarks:

Reported
#13 Brock

RECORD

Cased _____ in., _____ ft.

Sand _____

Gas _____

Oil _____

Total Depth _____

PRODUCTION

1st 24 hrs. Nat. _____

1st 24 hrs. after shot _____

Gas _____ Cu. Ft.

Dry Hole _____

Abandoned _____

Date


SEP 5 1951

19

J. E. TVRA

Scout

County Stafford State Kansas
 Sec. 12 (Blk. 23) (Sur. 12W) (Twsp.) Map No.
 Operator Beardmore Drlg.
 Well No. 3 Farm Brock
 Elev. 1830 Location SW NE SE

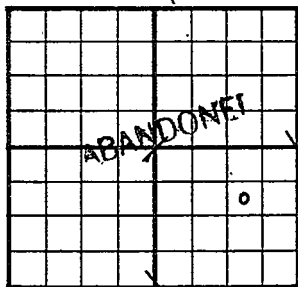990Ft. From N Line SE990Ft. From E Line Quarter

1st. Report

Completion SEP 5 1951Remarks Brock PoolSpudding Date 8-19-51Drlg. Data D & A TD 37258" @ 402 Anhy 585 Br. lime 3287KC 3317 Viola 3610 Simp. 3657Arb. 3719 DST 3719-25 open 1 hr.Rec. 165' sw TD 3725D & AVar