

KANSAS


FORM 91 5M BRIX

Stafford

Section 12 Township 23 Range 12W

Well No. #1 Vivin

Company Phillips

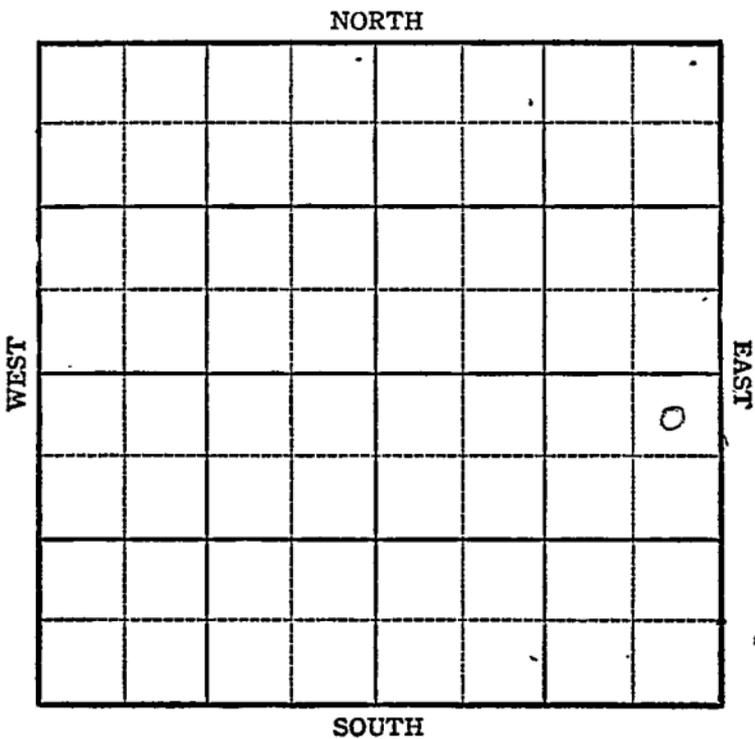

Stafford Co.

Wildcat

KANSAS

Sec. 12 Twp. 23 R. 12W

Well No. 1 Vivin Farm

Phillips Company

NE SE


NORTH

330 Ft. from N. Line

_____ Ft. from S. Line

330 Ft. from E. Line

_____ Ft. from W. Line

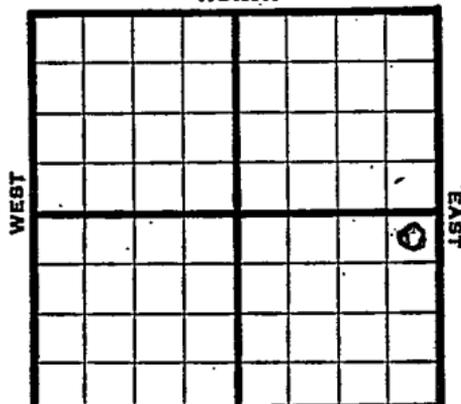

SOUTH

Edw. 1831

1944

REPORT

<p>9-13 9/21 9/28 10/4 10/11 10/18 10/25 11/1 11/8 11/15</p>	<p>Location RUR 8" @ 414 Drlg. 560 Drlg. 3140 Lams 3307 Cong. 3577 Viola 33587 Simp 3624 Arb 3679$\frac{1}{2}$ TD 3684 5" @ 3687 RUST TD 3684 swb 12 oil per hrs 4 hrs. 500 acid swb 191 oil in 14 hrs. " " " " " " " Pump 165 oil plus 4% wtr in 24 hrs. Arb. 3679$\frac{1}{2}$ -5" @ 3680 TD 3684 500 acid Pump 330 Pot. Grav. 37.</p>
---	--

COMPLETED


KANSAS

Pool Name WildcatMap No. 47 Sec. 12 Twp. 23 R. 12WWell No. 1 VivinPhillips Company

FIRST REPORT Contractor

NE SE

SECTION PLAT

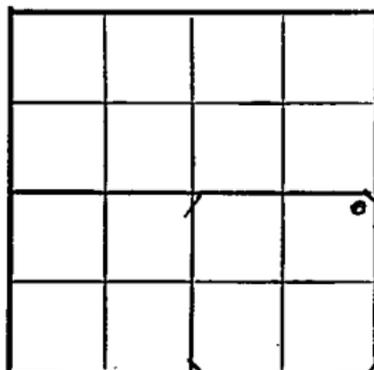330 Ft. from N. Line Ft. from S. Line330 Ft. from E. Line Ft. from W. Line

Stafford

Location XRig up

Drilling and Remarks:

RECORD

Cased in., ft.Sand Gas Oil Total Depth

PRODUCTION

1st 24 hrs. Nat. 1st 24 hrs. after shot Gas Cu. Ft.Dry Hole Abandoned

Date

SEP 13 1944 19S. J. LEWIS Scout

Pool Name Broch

Map No. 47 Sec. 12 Twp. 23 R. 12W

Well No. 1 Vivin

Phillips Company

COMPLETED

Contractor

NE SE

SECTION PLAT

330 Ft. from N. Line

 Ft. from S. Line

330 Ft. from E. Line

 Ft. from W. Line

			P

Stafford County

Location

Rig up

Drilling and Remarks:

Oil 3679 1/2

5" @ 3680

500 acid

Pump 330 Pst

37 Gr.

RECORD

Cased in., ft.

Sand

Gas

Oil

Total Depth 3684

PRODUCTION

1st 24 hrs. Nat.

1st 24 hrs. after shot

Gas Cu. Ft.

Dry Hole

Abandoned

Date

NOV 15 1944 19

S. J. LEWIS Scout