

Stafford **KANSAS** ✓
23 14W

12

Sec. _____ Twp. _____ R. _____

#1 Osborne Est. "A"

Well No. _____ Farm _____

Petroleum, Inc.

Company _____

Wildcat

Contractor _____

_____ Ft. from N. Line

330


_____ Ft. from S. Line

_____ Ft. from E. Line

330

_____ Ft. from W. Line

SW SW SE

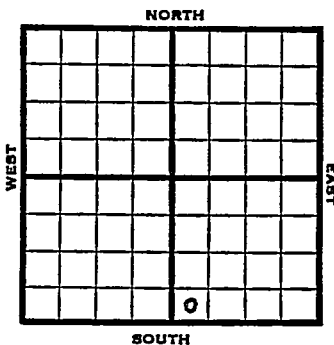

1953

Elev. 1914' REPORT

3/18

RUR

3/26

8" @ 221 Anhy 802'

Drlg. 3382'

4/1

Spud 3-17-53 D & A TD 3990'

8" @ 221 Anhy 802' Br line 3484

Lans. 3499

DST 3524-72 open 1 hr. rec 540+ gas, 63+ VSOCM 200#

DST 3617-32 open 1/2 hr. rec 8' mud

Viola 3834 Simp. 3902 Arb. 3956

TD 3990'

D & A

ABANDONED.

