


Section 12 Township 23 Range 16 WWell No. # 1 WurnCompany J. A. Terteling & Sons

NORTH

WEST

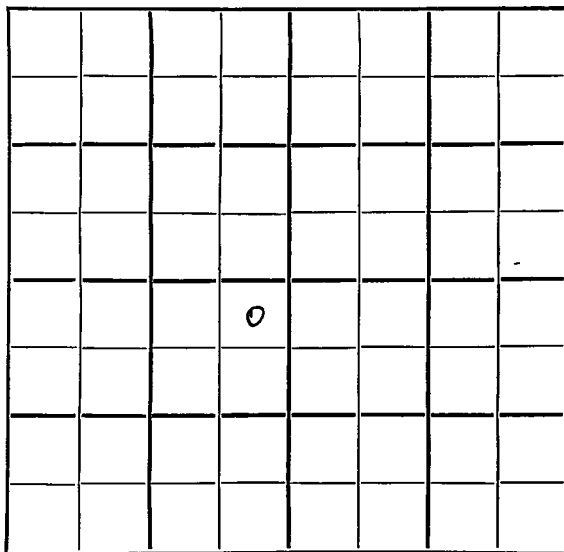

EAST

SOUTH

Pawnee	KANSAS	
SEC. 12	TWP. 23	R. 16 W

WELL NO. 12 23 16 W

COMPANY # 1 Wurn FARM

CONTRACTOR J. A. Terteling & Sons

Buick Drlg.


330 Wildecat

_____ Ft. from N. Line

_____ Ft. from S. Line

330 _____ Ft. from E. Line

_____ Ft. from W. Line

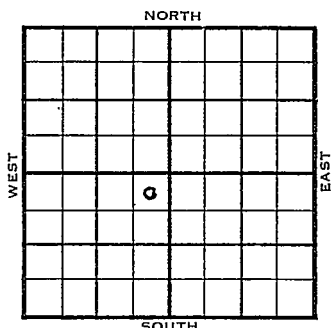

NE NE SW
Gulf - DHM

ELEVATION	REPORT
1953 2027'	

12/16	Spud 12-10-53 8" @ 200 Drlg. 2070'
1954 1/6	Spud 12-10-53 D & A TD 4186' 8" @ 200' Heeb 3510', Br. Lime 3629', Lans 3638' DST 3642'-80' opn 1 hr, rec 80' sw. 260# B KC 3898', Cong 3984', Viola 3994' DST 4021'-30' opn 3/4 hr, rec 180' wtr. 760# Simp 4100', Arb 4156' TD 4186' D & A

ABANDONED

County Pawnee State Kansas
 Sec. 12 (Blk.) 23 (Sur.) 16W Map No.
 (Twp.) (Rge.)

Operator J. A. Terteling & Sons

Well No. 1 Farm Wurn

Elev. _____ Location NE NE SW

330 Ft. From N Line SW

330 Ft. From E Line Quarter

1st. Report DEC 16 1953

Completion _____

Remarks Gulf - DEM

Buick Drlg. - Contr.


Spudding Date 12-10-53

Drlg. Data Wildcat

8" @ 200 drlg. 2070

J. G. McGEHEE

County Pawnee State Kansas
 Sec. 12 (Blk.) 23 (Sur.) 16W Map No.
 Operator J. A. Terteling & Sons
 Well No. 1 Farm Wurn
 Elev. 2027 Location NE NE SW

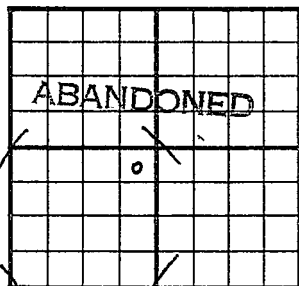

330 Ft. From N Line SW
330 Ft. From E Line Quarter
 Ist. Report
 Completion JAN 6 1954
 Remarks Wildcat
Buick Drlg. - Contr.
 Spudding Date 12-10-53

Drlg. Data D & A TD 4186
8" @ 200 Heeb. 3510 Br. lime 3629
Lans. 3638 DST 3642-80 open 1 hr.
Rec. 80' sw 260# B KC 3898 Cong. 3984
Viola 3994 DST 4021-30 open 3/4 hr.
Rec. 180' wtr. 760# Simp. 4100
Arb. 4156 TD 4186

D & A

J. G. McGEHEE