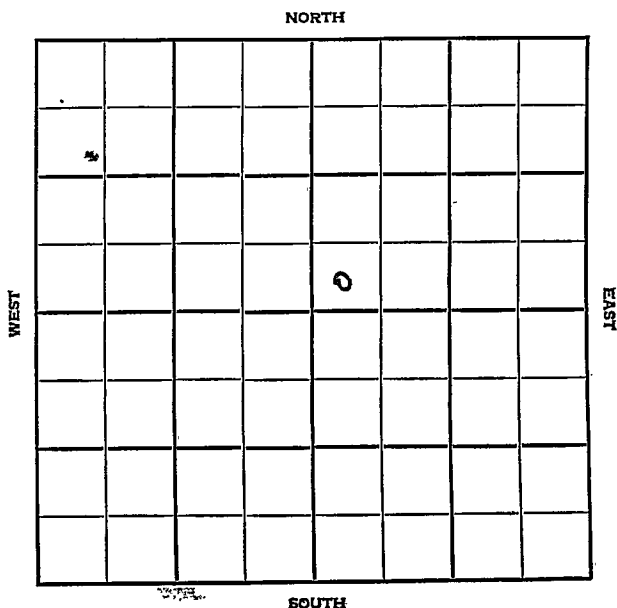


Section 12 Township 23 Range 17WWell No. 1 MartinCompany W. J. Coppinger

Pawnee		KANSAS	
SEC. 12	TWP. 23	R. 17W	
WELL NO. 1^M Martin			
COMPANY			FARM
CONTRACTOR W. J. Coppinger			


Wildcat

_____ Ft. from N. Line

330 _____ Ft. from S. Line

_____ Ft. from E. Line


330 _____ Ft. from W. Line

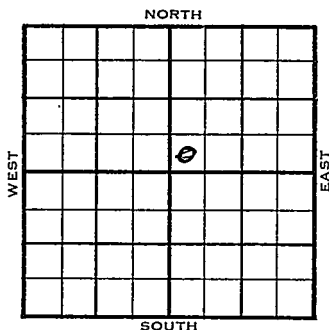

SW SW NE

	ELEVATION	REPORT
1954	2075'	
6/2	6/9	Celler & Pits
		8" @ 280'
		Anhy 1085'
		rlg. 2800'
6/23		Spud 6-2-54 D & A TD 4380
		8" @ 280 Anhy 1085 Heeb 3592'
		Tor. 3608 Br. lime 3703 Lans 3714
		B KC 4011 Cong. 4046
		DST 4100-22 open 1 hr rec 10' mud
		50# Viola 4157'
		DST 4155-67 open 1 hr rec 5' mud 10#
		DST 4192-4205 open 1 hr rec 30' mud
		20# Simp 4234' Arb. 4309'
		TD 4380' D & A
		ABANDONED

County Pawnee State Kansas
 Sec. 12 (Blk. Twp.) 23 (Sur. Rge.) 17W Map No. _____
 Operator W. J. Coppinger
 Well No. 1 Farm Martin
 Elev. _____ Location SW SW NE

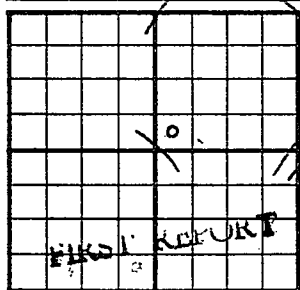

330 Ft. From S Line NE

330 Ft. From W Line Quarter

1st. Report JUN 2 1954

Completion _____


Remarks _____

Spudding Date _____

Drlg. Data Wildcat

Cellar & pits

J. G. McGEHEE

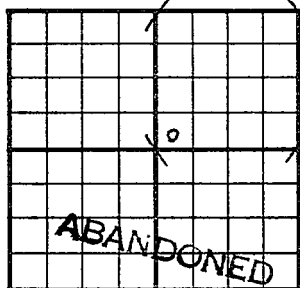County Pawnee State KansasSec. 12 (Blk. Twp.) 23 (Sur. Rge.) 17W Map No.Operator W. J. CoppingerWell No. 1 Farm MartinElev. 2075 Location SW SW NE330 Ft. From S Line NE330 Ft. From W Line Quarter

1st. Report

Completion JUN 23 1954Remarks WildcatSpudding Date 6-2-54Drlg. Data D & A TD 43808" @ 280 Anhy 1085 Heeb. 3592Tor. 3608 Br. lime 3703 Lans. 3714B KC 4011 Cong. 4046 DST 4100-22open 1 hr. Rec. 10' mud 50#Viola 4157 DST 4155-67 open 1 hr.Rec. 5' mud 10# DST 4192-4205 open 1 hrRec. 30' mud 20# Simp. 4234Arb. 4309 TD 4380D & A

J. G. McGEHEE