


Finney

Section 12 Township 23 Range 33WWell No. 1 FriesenCompany Northern Pump

NORTH

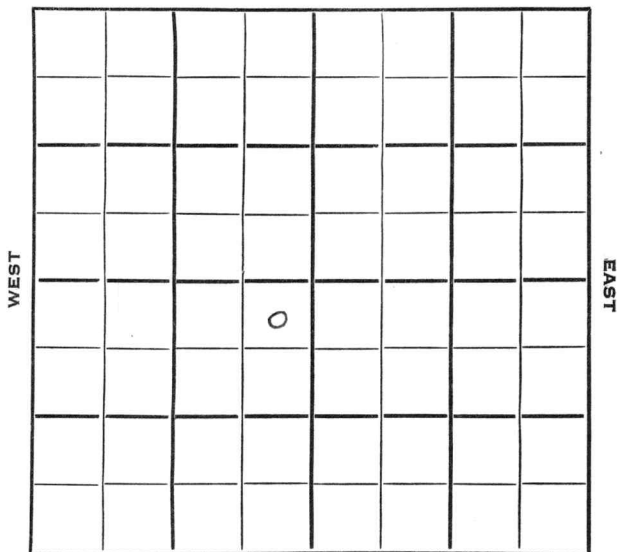

SOUTH

Finney KANSAS ✓

Sec. 12 Twp. 23 R. 33 WWell No. # 1 Friesen FarmNorthern Pump Company

Contractor


150 Ft. from N. Line

Ft. from S. Line

150 Ft. from E. Line

Ft. from W. Line

NE SW

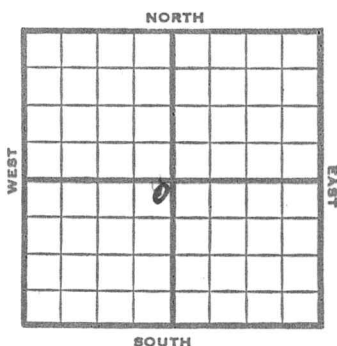

1953

Elev. 2865 REPORT

1/21

Spud 1-13-53  
9" @ 338

1/29

Drlg. 2630'  
Her 2525' Kr. 2542' Win 2584'  
RTD 2596'

2/5

NR

2/12

TD 2601  
6" @ 2586  
5000A  
Plug 2570, 40/2526-36, 3000A

2/19

11,000A

2/25

Spud 1-13-53  
Gas Well  
TD 2601  
9" @ 338  
Her 2525, Kri 2542, Win 2584  
TD 2596  
6" @ 2586  
DD 2601, 5000A SP 2570  
40/2526-36, 3000A  
11000 A  
Comp. 13,750,000 gas 427#

COMPLETED

County

Finney

## State

Kansas

Sec.

12

(Blk.)  
(Twp.)

23

(Sur.)  
(Rge.)

33W

Map No.

Operator

## Northern Pump

Well No.

1

Farm

## Friesen

Elev.

### Location

NE SW

0

FIRST REPORT

150

Ft. From

N Line

SV

150

Ft. From

Line

Quarter

1st. Report

JAN

21

1

74

953

### Completion

Remarks

Spudding Date

1-13-53

Drig. Data

9" @ 338

drlg. 2630

J. G. McGEHEE

County Finney State Kansas

Sec. 12 (Blk. Twp.) 23 (Sur. Rge.) 33W Map No.

Operator Northern Pump

Well No. 1 Farm Friesen

|       |      |          |       |
|-------|------|----------|-------|
| Elev. | 2865 | Location | NE SW |
|-------|------|----------|-------|

A 10x10 grid with a small circle in the 5th row, 4th column and the word 'COMPLETE' diagonally across the bottom right.

150 Ft. From N Line SW

150 Ft. From E Line Quarter

1st. Report

Completion FEB 25 1953

Remarks

Spudding Date 1-13-53

Drilg. Data      Gas well      TD 2601

9" @ 338 Her. 2525 Kri. 2542

Win. 2584    TD 2596    6" @ 2586    DD 2601

5000 A      SP 2570      40/ 2526-36      3000 A

11000 A      Comp. 13,750,000 gas      427#