

Kearny

KANSAS

FORM 51 25M 3-49 PETROL

Section 12 Township 23 Range 35W

Well No. #1 Hill "B"

Company Cities Service

NORTH

				0			

WEST

EAST

SOUTH

Sec. 12 Twp. 23 R. 35W ✓

Well No. #1 Hill "B" Farm

Cites Service Company

Hugoton Pool Contractor

Ft. from N. Line

100'


Ft. from S. Line

Ft. from E. Line

100'

Ft. from W. Line

SW NE

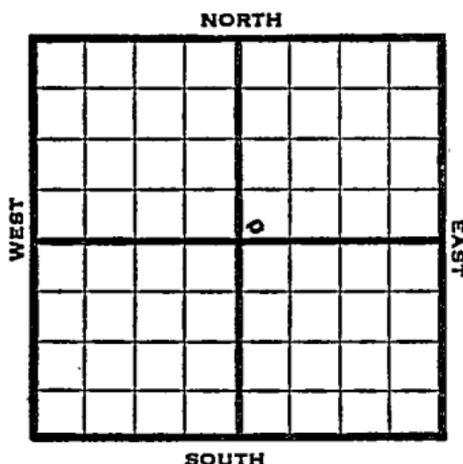

1950

Elev. 2993' REPORT

5/3

Location

6/7

8" @ 520'

5" @ 2674'

Krider 2502'

Win 2559'

Up Ft R 2624'

Opn flow 2,330,000 CFGPD

TD 2675'

COMPLETED

Kansas

Hugoton Pool

Map No. _____ Sec. 12 Twp. 23 R. 35WWell No. 1 Hill "B"

_____ Cities Service _____ Company

_____ Contractor

SW NE

SECTION PLAT

_____ Ft. from N. Line

100 Ft. from S. Line

_____ Ft. from E. Line

100 Ft. from W. Line

Kearny County

Location X

Rig up _____

Drilling and Remarks:

RECORD

Cased _____ in., _____ ft.

Sand _____

Gas _____

Oil _____

Total Depth _____

PRODUCTION

1st 24 hrs. Nat. _____

1st 24 hrs. after shot _____

Gas _____ Cu. Ft.

Dry Hole _____

Abandoned _____

Date

MAY 3 1950 19J. E. TYRÁ

Scout

Kansas

Map No. _____ Sec. 12 Twp. 23 R. 35W

Well No. 1 Hill "B"

Cities Service _____ Company

SW NE _____ E1.2993 _____ Contractor


SECTION PLAT

_____ Ft. from N. Line

100 Ft. from S. Line

_____ Ft. from E. Line

100 Ft. from W. Line

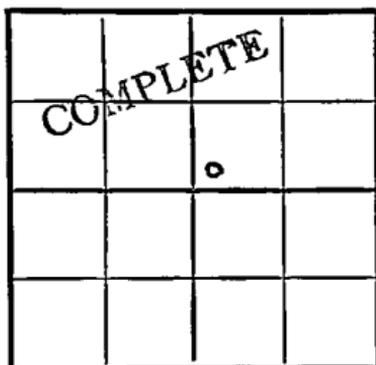

Kearny

Location _____

Rig up _____

Drilling and Remarks:

8" @ 520
 5" @ 2674
 Krider 2502
 Win 2559
 up str. 2624
 open flow

RECORD

Cased _____ in., _____ ft.

Sand _____

Gas _____

Oil _____

Total Depth 2675

PRODUCTION

1st 24 hrs. Nat. _____

1st 24 hrs. after shot _____

Gas _____ Cu. Ft.

Dry Hole _____

Abandoned _____

Date

2,330,000 CFBPD.

JUN 7th 1950

19

J. E. TYNA Scout