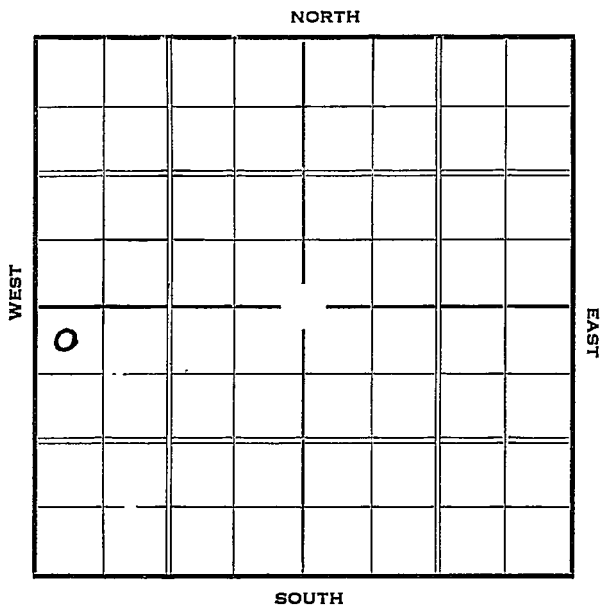


Section 13 Township 23 Range 2-WWell Number 1 HauryCompany Bradley

KANSAS

Sec. 13 Twp. 23 R. 2-W

Well No. 1 Haury Farm

Bradley Company


330 Ft. from N. Line

Ft. from S. Line

Ft. from E. Line

330 Ft. from W. Line

Elev. 1428

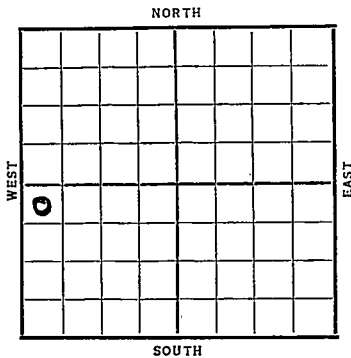[illegible]

KANSAS

Map No. 39 Sec. 13 Twp. 23 R. 24Well No. 1 NauryBradley Company

Contractor

SECTION PLAT

0			

330 Ft. from N. Line

_____ Ft. from S. Line

_____ Ft. from E. Line

330 Ft. from W. Line

FIRST REPORT

Location _____

Rig up _____

Drilling and Remarks:

Rig

RECORD

Cased _____ in., _____ ft.

Sand _____

Gas _____

Oil _____

Total Depth _____

PRODUCTION

1st 24 hrs. Nat. _____

1st 24 hrs. after shot _____

Gas _____ Cu. Ft.

Dry Hole _____

Abandoned _____

Date

JAN 6 1937 19

S. J. LEWIS Scout

KANSAS

Map No. Harvey 39 Sec. 13 Twp. 23 R. 2W.Well No. 1 HarveyCompany Bradley

Contractor

SECTION PLAT

330 Ft. from N. Line

_____ Ft. from S. Line

_____ Ft. from E. Line

330 Ft. from W. Line

0			

ABANDONED

Location _____

Rig up _____

Drilling and Remarks:

Chas. 2979No oil or water

RECORD

Cased _____ in., _____ ft.

Sand _____

Gas _____

Oil _____

Total Depth 2996

PRODUCTION

1st 24 hrs. Nat. _____

1st 24 hrs. after shot _____

Gas _____ Cu. Ft.

Dry Hole ☒Abandoned ☒

Date

MAR 10 1937

19

S. J. LEWIS

Scout