


Harvey

KANSAS

SECTION 13 TOWNSHIP 23 RANGE 2W

WELL NO. #1 Hertzler

COMPANY Cherry Drlg. Co., etal

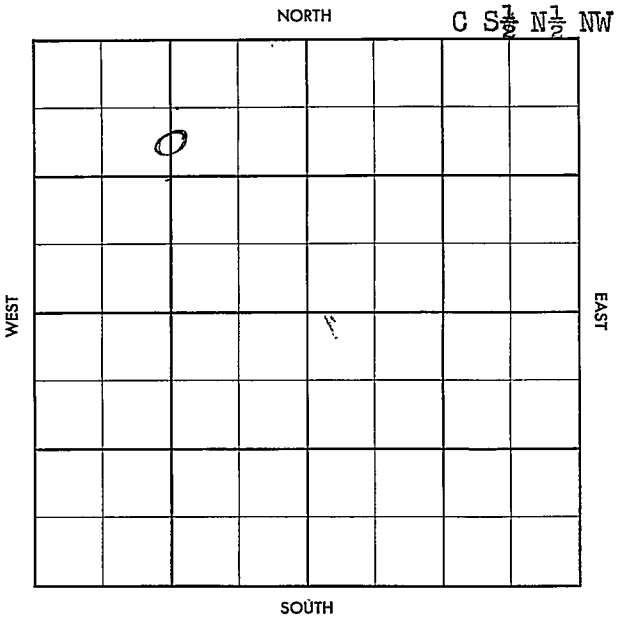

County HarveyElev. 1447Sec. 13Twp. 23Rge. 2WCompany Cherry Drlg. Co. etalFarm Name HertzlerNo. 1

TOPS	DEPTH	LOG	DATUM	Loc. in Sec.
Anb.				C S ¹ / ₂ N ¹ / ₂ NW
TP.				
H.	2120			
Tr.				
Dg.				
Bl.	2358			
L.	2364			Geol.
K.C.				Contr.
B.K.C.	2745			Cc. Tools
Ce.				Pool
C.	2978			Halstead
M. <u>chat</u>	2980			
M. <u>Dolo</u>	3005			
K.	3298			
Mz.	3308			
Mo. <u>Hunt</u>	3311			
V. <u>Mash</u>	3375			
S. <u>110</u>	3419			
S.				
A.				
R.				
PE.				
G.				
TR.	3413			

MAY 8 57

ABANDONED

Date Comm. 4-16-57

Spudding

APR 24 '57

8578 226

2700

MAY 1 '57

MAY 8 '57

DEA ~~total~~