


Map No. 1445 Sec. 13 Twp. 23 R. 4W
 Well No. 1 Robin Farm
Payson 3/4 Empire 1/4 Company

NORTH

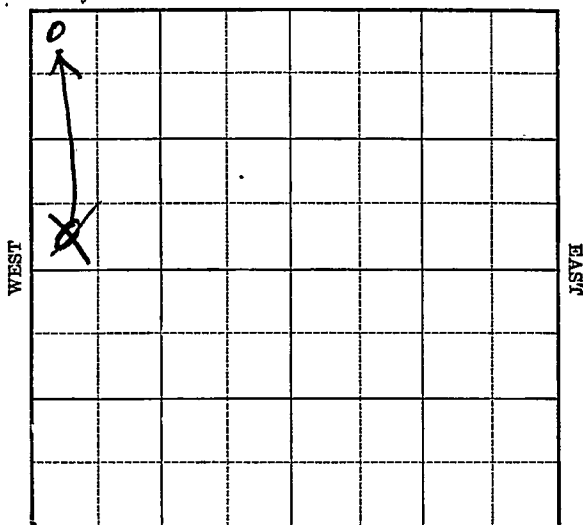

SOUTH

Location _____
 Drilling Remarks _____

Rig Up _____
 Drilling Remarks _____

RECORD

Cased _____ in. _____ ft.
 Sand _____
 Gas _____
 Oil _____
 Total Depth _____


PRODUCTION

1st 24 hrs. Nat. _____
 1st 24 hrs. after shot _____
 Gas _____ cu. ft.
 Dry Hole _____
 Abandoned _____

Reno

Map No. KANSAS Sec. 13 Twp. 23 R. 4WWell No. 1 Robin Farm
Hypsey 3/4 & Empire 1/4 Company330 Ft. from N. Line~~330~~ Ft. from S. Line

Ft. from E. Line

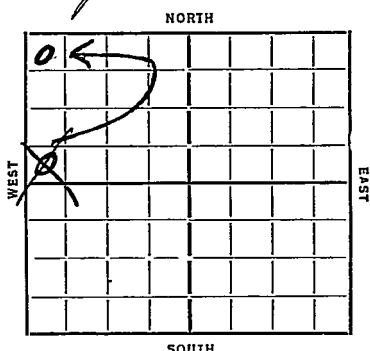330 Ft. from W. Line

Date

REPORT

11/14 Location
 11/22 Cellar
 11/28
 12/6 Bldg.
 12/13 15 1/2 248 WOC
 12/21 Dlg 750 17 1/2 595
 12/27 " 2830
 1/3/35 " 3268 TML 3260
 1/10 " 3609 MML 3505
 1/17 Hutton 3611 8" 3268
 Run 6" to Hutton
 1/24 7" 3609 Dlg cement
 1/31 36 1/2" 2 T D Arch 35 oil 50 W
 12 hrs.
 2/7 54 oil 1371 water 24 hrs.
 2/14 PB to Chat
 2/21 PB 3515 Pulled 6" ext 12 m Gas
 & SW
 2/28 PB 3379 8 m Gas & spray oil
 3/7 ~~Log~~ Tubing
 3/14 " 9 m Gas

(OVER)

3/20 Hinton 3611
T 7 3612 1/2
PB 3378
11 M Gas.

COMPLETED

Map No. 40 Sec. 13 Twp. 23 R. 4^N

Well No. 1- Robin

Gypsy 3/4ths + Empire 1/4 Company

Contractor

FIRST REPORTS

SECTION PLAT

0			

_____ Ft. from N. Line

330 Ft. from S. Line

_____ Ft. from E. Line

330 Ft. from W. Line

Location ✓

Rig up _____

Drilling and Remarks:

RECORD

Cased _____ in., _____ ft.

Sand _____

Gas _____

Oil _____

Total Depth _____

PRODUCTION

1st 24 hrs. Nat. _____

1st 24 hrs. after shot _____

Gas _____ Cu. Ft.

Dry Hole _____

Abandoned _____

Date

ORVAL MANNSCHRECK

11-14-34 19

Scout

Map No. 40 Sec. 13 Twp. 23 R. 4WWell No. 1 - SabinHypsy & Empire Company

Contractor

CORRECTION

330 Ft. from N. Line

Ft. from S. Line

Ft. from E. Line

330 Ft. from W. Line

CORRECTION

SECTION PLAT

0			

Location

Rig up

Drilling and Remarks:

formerly reported
in SW NW

RECORD

Cased in, ft.

Sand

Gas

Oil

Total Depth

PRODUCTION

1st 24 hrs. Nat.

1st 24 hrs. after shot

Gas Cu. Ft.

Dry Hole

Abandoned

Date

ORVAL MANNSCHRECK

11-27-34 192 Scout

KANSAS

Map No. 40 Sec. 13 Twp. 23 R. 4WWell No. 1- SahinHyers 3/4 ths Eng 4 CompanyCOMPLETE Contractor

SECTION PLAT

330 Ft. from N. Line

..... Ft. from S. Line

..... Ft. from E. Line

330 Ft. from W. Line

0			

Location.....

Rig up.....

Drilling and Remarks:

P. B. 337811 m gas

RECORD

Cased..... in., ft.

Sand Hutton 3611

Gas.....

Oil.....

Total Depth 3612 1/2

PRODUCTION

1st 24 hrs. Nat.....

1st 24 hrs. after shot.....

Gas..... Cu. Ft.

Dry Hole.....

Abandoned.....

Date

3-20-35 192ORVAL MANNSCHRECK
Scout