

KANSAS


Reno

FORM 51 5M 2-38 TPCO.

Section 13 Township 23 Range 4-W

Well No. #1 Sabin

Company Colorado Syndicate

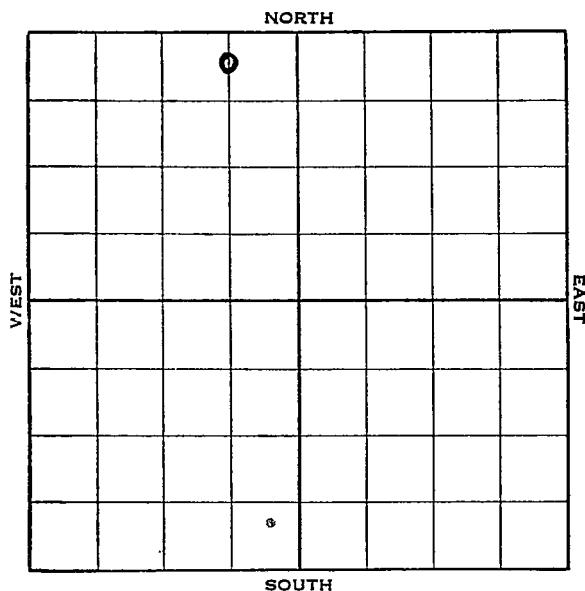

3

KANSAS


Sec. 13 Twp. 23 R. 4-WWell No. #1 Sabin FarmColorado Syndicate Company330 CNL NE NW
Ft. from N. Line

Ft. from S. Line

660 Ft. from E. Line

Ft. from W. Line

Elev. 1481

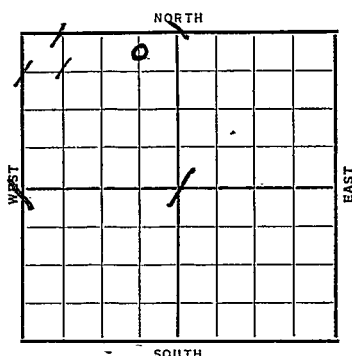

Date	REPORT
1938	
6/29	RUR
7/8	12" - 249'. Drlg. 1543'.
7/15	Dlg. 2958'.
7/22	Chat 3268'. T.D. 3415'.
	6" - 3415'. No shows.
7/29	Perf. 80 shots 3345-65'.
	2500 acid. Est. 2½ M gas.
	Spraying oil.
8/5	48 shots 3365-73'.
	Flowed 2 oil & 30 water in
	24 hrs. S.D.O.
8/12	" " "
8/19	" " "
8/24	Chat. 3268'.
	T. D. 3415'.
	Perf. csg.
	2500 acid.
	Potential 50 bbls.
	COMPLETED

Reno

KANSAS

Map No. 40 Sec. 13 Twp. 23 R. 4WWell No. 1 SabinColorado Syndicate Company


Contractor

FIRST REPORT

C N L NE NW

330 Ft. from N. Line Ft. from S. Line660 Ft. from E. Line Ft. from W. Line

SECTION PLAT

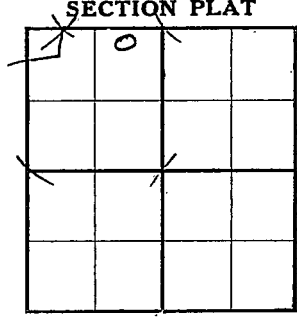Location Rig up

Drilling and Remarks:

RUR

RECORD

Cased in., ft.Sand Gas Oil Total Depth

PRODUCTION

1st 24 hrs. Nat. 1st 24 hrs. after shot Gas Cu. Ft.Dry Hole Abandoned

Date

JUN 29 1938 19 H. D. Hatfield Scout

Reno

KANSAS

Map No. 40 Sec. 13 Twp. 23 R. 4WWell No. 1 SabinColorado Syndicate Company

Contractor

COMPLETED

C N L NE NW

330 Ft. from N. Line

Ft. from S. Line

660 Ft. from E. Line

Ft. from W. Line

SECTION PLAT

	0		

Location

RECORD

Rig up

Cased _____ in., _____ ft.

Drilling and Remarks:

Sand Chat 3268

Gas _____

Oil _____

Total Depth 3415

PRODUCTION

1st 24 hrs. Nat. _____

1st 24 hrs. after shot _____

Gas _____ Cu. Ft.

Dry Hole _____

Abandoned _____

Date

AUG 24 1938

19

H. D. Hatfield Scout