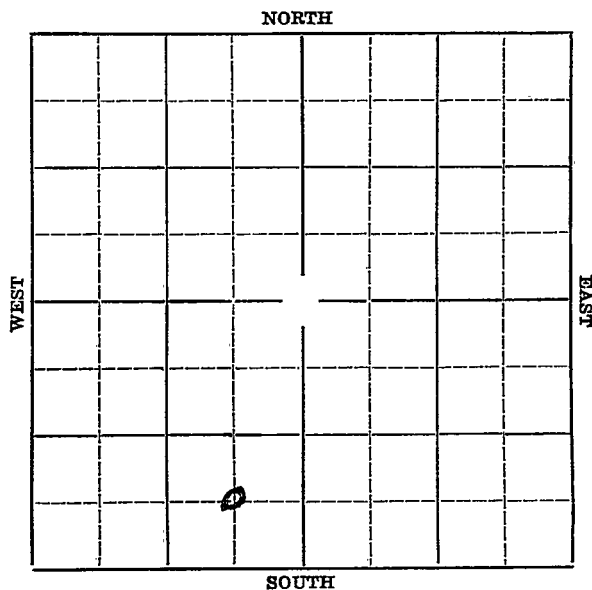


Section 13 Township 23 Range 4-WWell Number 4-SabinCompany Olsen & Shell


Map No. _____ Sec. 13 Twp. 23 R. 4WWell No. #4 Sabin FarmOlson & Shell Company

_____ Ft. from N. Line

660' Ft. from S. Line660' Ft. from E. Line

_____ Ft. from W. Line

Elev. 1469

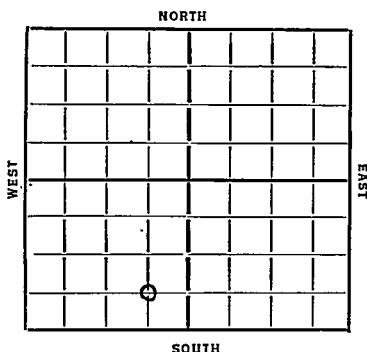

Date	REPORT
1936	
4/29	Location
5/7	-- 5/14-- 5/21-- 5/28-- 6/4-- 6/11--
6/18	--
6/25	Drlg. 960'.
7/2	Drlg. 2675'.
7/9	Drlg. 3044'.
7/16	Chat 3253'. T.D. 3274'. Rust.
7/23	7" @ 3274'. TD 3374'. Run tubing . 8 million cubic feet of gas.
7/29/36	Chat 3253'. T.D. 3374'. 1000 gallons of acid. 8 million cubic feet of gas. 84 bbls of oil.
	COMPLETED

Map No. 40 Sec. 13 Twp. 23 R. 4WWell No. 4 SabinOlson & Shell Company

Contractor

SECTION PLAT

	0		

Ft. from N. Line

660 Ft. from S. Line660 Ft. from E. Line

Ft. from W. Line

FIRST REPORT

Location ✓

Rig up

Drilling and Remarks:

RECORD

Cased _____ in., _____ ft.

Sand _____

Gas _____

Oil _____

Total Depth _____

PRODUCTION

1st 24 hrs. Nat. _____

1st 24 hrs. after shot _____

Gas _____ Cu. Ft.

Dry Hole _____

Abandoned _____

Date

APR 29 1936

192

S I LEWIS

Scout

KANSAS

Map No. 48 Sec. 13 Twp. 23 R. 4WWell No. 4 Gas in "B"Olson & Shell Company

Contractor

SECTION PLAT

	0		

_____ Ft. from N. Line

660 Ft. from S. Line660 Ft. from E. Line

_____ Ft. from W. Line

COMPLETED

Location _____

Rig up _____

Drilling and Remarks:

@ ha 8 32531000 acid8 M Gas.848 lb. oil

RECORD

Cased _____ in., _____ ft.

Sand _____

Gas _____

Oil _____

Total Depth 3374

PRODUCTION

1st 24 hrs. Nat. _____

1st 24 hrs. after shot _____

Gas _____ Cu. Ft.

Dry Hole _____

Abandoned _____

Date

JUL 29 1936 19S. J. LEWIS Scout