


Map No. 71 Sec. 13 Twp. 23 R. 8^W
Well No. 1 - Short Farm
Engler & Reno Oil Company

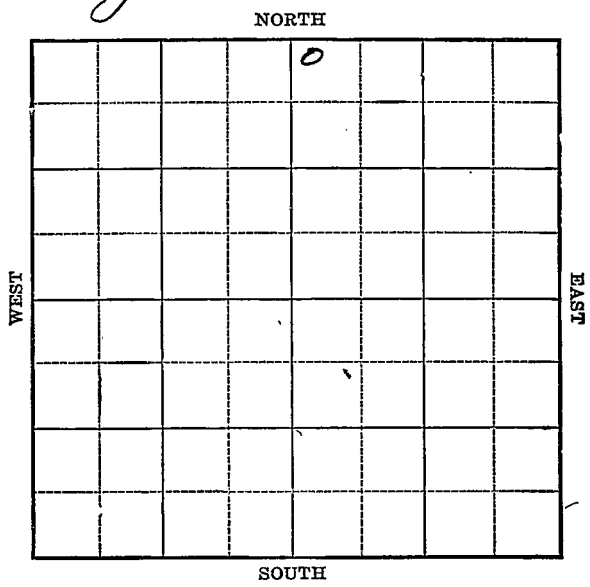

Location _____

Drilling Remarks:

RECORD

Cased _____ in. _____ ft.

Sand _____

Gas _____

Oil _____

Total Depth _____

Rig Up _____

Drilling Remarks:

PRODUCTION

1st 24 hrs. Nat. _____

1st 24 hrs. after shot _____

Gas _____ cu. ft.


Dry Hole _____

Abandoned _____

Map No. K Sec. 13 Twp. 23 R. 8^WWell No. 1 Short FarmEngler Ed Reno Oil Company700 Ft. from N. Line

_____ Ft. from S. Line

_____ Ft. from E. Line

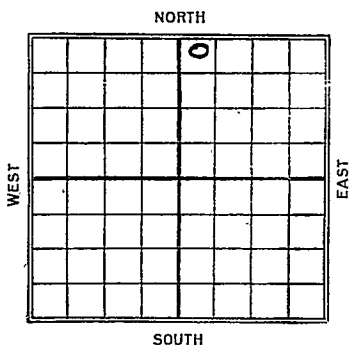700 Ft. from W. LineBeneas

REPORT

Date

4/9 Location4/24 _____11/22 S.D. @ 3506'1925 _____1/21 _____19254/2 D + A 3732Will Complete

Map No. Reino Co. No Map Sec. 13 Twp. 23 R. 2WWell No. #1 shortEngler & Reino Oil Company

Contractor

FIRST REPORT

SECTION PLAT

200 Ft. from N. Line

Ft. from S. Line

Ft. from E. Line

200 Ft. from W. Line

		0	

Location ✓✓

Rig up

Drilling and Remarks:

RECORD

Cased _____ in., _____ ft.

Sand _____

Gas _____

Oil _____

Total Depth _____

PRODUCTION

1st 24 hrs. Nat. _____

1st 24 hrs. after shot _____

Gas _____ Cu. Ft.

Dry Hole _____

Abandoned _____

Date
APR 9 1924

M. A. BENEAR

192


Scout

MAP No. _____ SEC. 13 TWP. 23S R. 8WWELL No. 1 HartPeno Oil

COMPANY _____

CONTRACTOR _____

SECTION PLAT

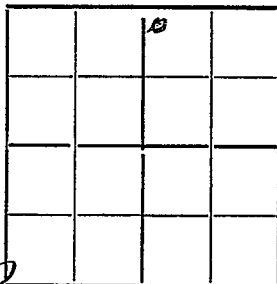

_____ FT. FROM N. LINE

_____ FT. FROM S. LINE

_____ FT. FROM E. LINE

_____ FT. FROM W. LINE

no wall
map

RECORD

LOCATION _____

CASED _____ IN. _____ FT.

RIG UP _____

SAND _____

DRILLING AND REMARKS:

GAS _____

OIL _____

TOTAL DEPTH 3176

PRODUCTION

1ST 24 HRS. NAT. _____

1ST 24 HRS. AFTER SHOT _____

GAS _____ CU. FT.

DRY HOLE ☒ABANDONED ☒

DATE

6/4 5

192

SCOUT

Map No. _____ Sec. 13 Twp. 23 R. 8WWell No. 1 shortEnglebert et al Company_____
Contractor

ABANDONED.

SECTION PLAT

200' Ft. from N. Line

_____ Ft. from S. Line

_____ Ft. from E. Line

200' Ft. from W. Line

		0	

Location _____

Rig up _____

Drilling and Remarks:

40 x 9
3722

RECORD

Cased _____ in., _____ ft.

Sand _____

Gas _____

Oil _____

Total Depth _____

PRODUCTION

1st 24 hrs. Nat. _____

1st 24 hrs. after shot _____

Gas _____ Cu. Ft.

Dry Hole _____

Abandoned _____

Date

6/9 1925 3722 Scout