


Section 13 Township 23 Range 9 W

Well No. #1 Krenzin

Company Rupp-Ferguson Oil

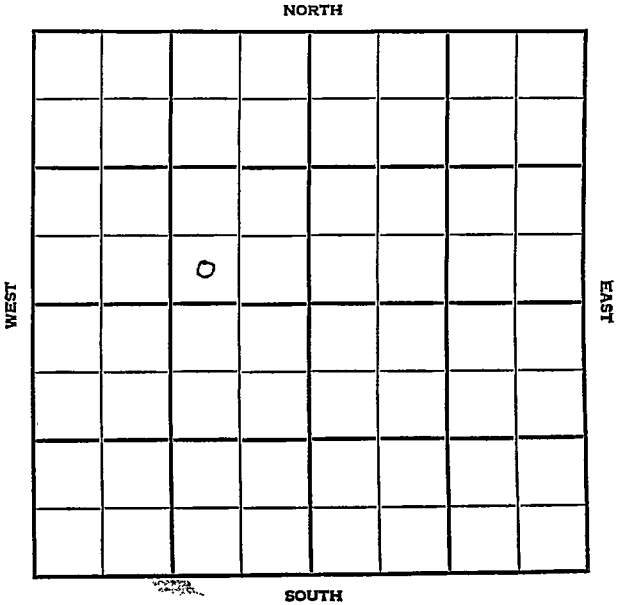

County Beno Elev. _____
 Sec. 13 Twp. 23 Rge. 9W
 Company Rupp-Ferguson Oil
 Farm Name Krenzin No. 1

Co.

Loc.

No.

Sec.

T.

R.

TOPS

DEPTH

LOG

DATUM

Loc. in Sec. _____

Anh.

Tp.

H.

Tr.

Dg.

Bl.

L.

K.C.

B.K.C.

Ce.

C.

M.

M.

K.

Mz.

Me.

V.

S.

S.

A.

R.

P.E.

G.

T.D.

SW SE NW


Geol. _____

Contr. _____

Co. tools

Pool

Wildcat

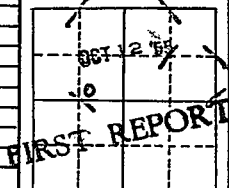

FIRST REPORT

Date Comm. 10-10-55
8" @ 235/200 WOC

County Reno Elev. 1707 RD
1704 DF
 Sec. 13 Twp. 23 Rge. 9W
 Company Papp-Ferguson Oil
 Farm Name Krenzin No. 1

TOPS	DEPTH	LOG	DATUM	Loc. in Sec.
Anh.				SW SE NW.
Tr.				
H.	3049		1345	
Tr.				
Dg.	3076		1372	
BL.	3214	3204	1500	
L.	3239	3230	1526	Geol.
K.C.				
B.K.C.				Contr.
Ce. <u>Marm</u>	3600	3599	1895	Co. tools
C.	3702	3699	1995	
M.	3721	3721	2017	Pool
M.				Wildcat
K.				
Mz.				
Mq.				
V.				
S.				
S.				
A.				
R.				
PE.				
G.				
T.D.	3743	3741		

Date Comm. 10-10-55 OCT 26 1955
 8" @ 235/200 DST 3699-3711 open 1 hr.
 Rec. 15' mud 0/20" DST 3722-43
 open 1 hr. - rec. 20' mud 20/20"

D & A

O.W.W.O.

FORM 513 SUNRAY

County Reno Elev. 1719
Sec. 11 Twp. 23 Rge. 9W
Company Ambassador Oil
Farm Name Prettyman No. 1

TOPS	DEPTH	LOG	DATUM
Anh.			
Tr.			
H.			
Tr.			
Dg.			
BL.			
L.		3194	
K.C.			
B.K.C.			
Ce.			
C.			
M.			
M.			
K.			
Mz.			
Mq.			
V.			
S.			
S.			
A		3893	
R.			
PE.			
G.			
T.D.			

Loc. in Sec. NE NE NW
O.W.W.O.
Geol. RAI RAI (O)
Contr.
Pool



Date Comm. 5th @ 3360 OTD 3900 44/ 3244-50
1000 A S/ 2 boph dec. to 1/2 boph
abd. in 1955 F/ 40 bo 2 hr.
S/ 140 bo 18 hr. SI 12 hr.
P/ 54 bo 17 hr. P/ 67 bo 24 hr.
P/ 40 bo 24 hr. Comp. 18 bopd 1% wtr.

12