


Section 13 Township 23 Range 10W

Well No. 1 Dlasdell (Blasdell)

Company Pickrell

Peach Creek
NORTH

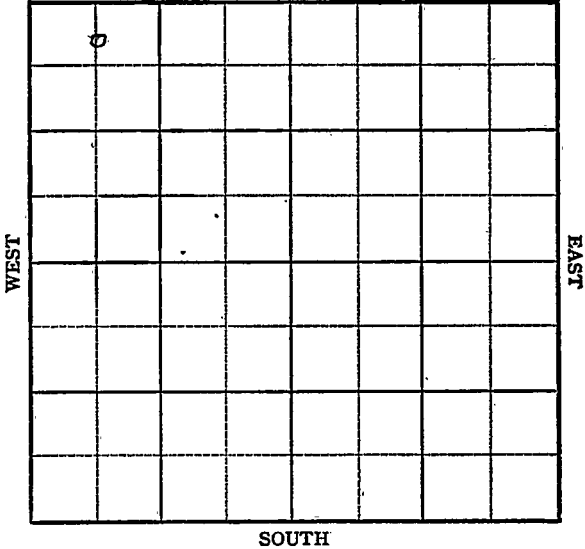

Sec. 13 Twp. 23 R. 10W

Well No. #1 Dlasdell Farm
Pickrell Company

Peace Creek


330' Ft. from N. Line

_____ Ft. from S. Line

_____ Ft. from E. Line

660' Ft. from W. Line

C N L NW NW

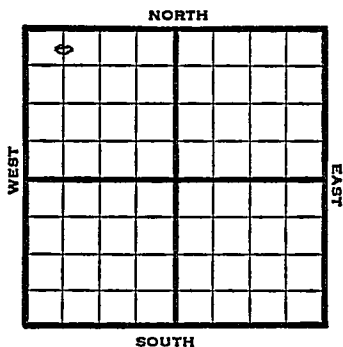

1949

Elev 1759' REPORT

2/9 All wells plugged

8" @221'

Drlg. 2000'

2/16 Drlg. 2756'

2/23 TD 3774'

Viola 3756'

Aband.

ABANDONED

Kansas

Pearce Creek

Map No. _____ Sec. 13 Twp. 23 R. 10 WWell No. 1 D SandellPicknell

Company

FIRST REPORT

Contractor

ENL NWNW

SECTION PLAT

3			

330 Ft. from N. Line

_____ Ft. from S. Line

_____ Ft. from E. Line

660 Ft. from W. LinePeno

Location _____

Rig up _____

Drilling and Remarks:

*all wells plugged
8" @ 221'
2000'*

RECORD

Cased _____ in., _____ ft.

Sand _____

Gas _____

Oil _____

Total Depth _____

PRODUCTION

1st 24 hrs. Nat. _____

1st 24 hrs. after shot _____

Gas _____ Cu. Ft.

Dry Hole _____

Abandoned _____

Date

FEB 9 1949 19S. J. LEWIS

Scout

Kansas

Map No. 247 Sec. 13 Twp. 23 R. 10WWell No. 1 DlasdellPickrell Company**ABANDONED**

Contractor

C N L NW NW

E 11759
SECTION PLAT330 Ft. from N. Line Ft. from S. Line Ft. from E. Line660 Ft. from W. Line

4			

Reno County

Location _____

Rig up _____

Drilling and Remarks:

No log 206.

RECORD

Cased _____ in., _____ ft.

Sand _____

Gas _____

Oil _____

Total Depth 3774

PRODUCTION

1st 24 hrs. Nat. _____

1st 24 hrs. after shot _____

Gas _____ Cu. Ft.

Dry Hole _____

Abandoned _____

Date

FEB 23 1949 19

S. J. LEWIS Scout