

FORM 51 5M 10-41 PETROL


Reno

Section 13 Township 23 Range 10-W

Well No. #3 Blasdell

Company Barnsdall

Peace Creek Pool NORTH

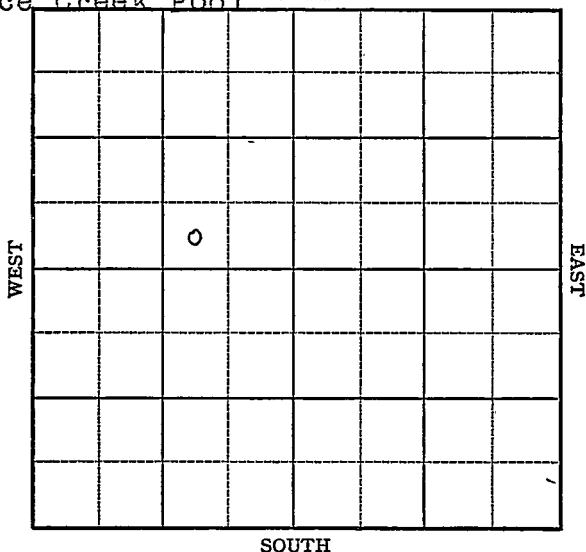

KANSAS

Reno

Sec. 13 Twp. 23 R. 10-W

Well No. #3 Blasdell Farm

Barnsdall

Company

(Peace Creek Pool)


 Ft. from N. Line

330 Ft. from S. Line

990 Ft. from E. Line

 Ft. from W. Line

Elev. 1756'

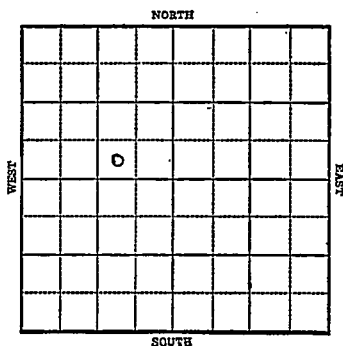

1942

R E P O R T

10/7	Derrick
10/14	10" @ 315 Drlg. 1350'
10/21	Drlg 3009'
10/28	Miss 3590
	Viola 3757-3762
	TD 7" @3757 Rust
11/4	TD 3768 fsg tubing
11/11	" " "
11/18	" " "
11/24	TD 3768'
	Pump 11 oil in 2 hrs. plus 43% water
	1000 acid.
12/2	" " "
12/9	Viola 3757
	7" - 3760
	1000 acid
	T.D. 3768
	Pump 60 Pot.
	Gravity 42.

COMPLETED

Reno

KANSAS

Map No. 47 Sec. 13 Twp. 23 R. 10WWell No. 3 BlasdellBarnsdall


Company

FIRST REPORT

Contractor

SW SE NW

SECTION. PLAT

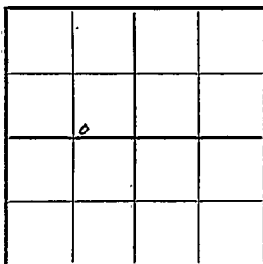 Ft. from N. Line330 Ft. from S. Line990 Ft. from E. Line Ft. from W. LinePEACE CREEK POOLLocation Rig up

Drilling and Remarks:

Derrick

RECORD

Cased in., ft.Sand Gas Oil Total Depth

PRODUCTION

1st 24 hrs. Nat. 1st 24 hrs. after shot Gas Cu. Ft.Dry Hole Abandoned


Date

OCT 7 1942 19S. J. LEWIS Scout

Map No. 47 Sec. 13 Twp. 23 R. 10WWell No. 3 BlasdellBarnsdall CompanyCOMPLETED Contractor

SW SE NW

SECTION PLAT

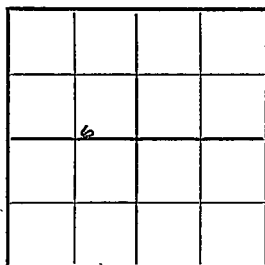 Ft. from N. Line330 Ft. from S. Line990 Ft. from E. Line Ft. from W. Line

PEACE CREEK POOL

Location Rig up

Drilling and Remarks:

*Vista 3757**7" @ 3760**1000 acid**Pump 60 Rod**42° S*

RECORD

Cased in., ft.Sand Gas Oil Total Depth 3768

PRODUCTION

1st 24 hrs. Nat. 1st 24 hrs. after shot Gas Cu. Ft.Dry Hole Abandoned

Date

DEC 9 1942 19 S. J. LEWIS Scout