


KANSAS

Stafford County

Section 13 Township 23 Range 12W

Well No. #1 C. B. Hughes

Company Stanolind

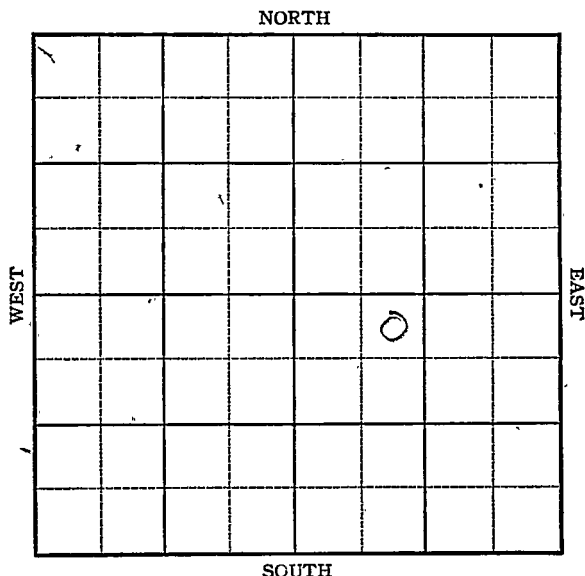

KANSAS

Stafford Co.

Sec. 13 Twp. 23S R. 12W

Well No. #1 C. B. Hughes Farm

Stanolind Company


Wildcat

330 Ft. from N. Line

Ft. from S. Line

Ft. from E. Line

990 Ft. from W. Line

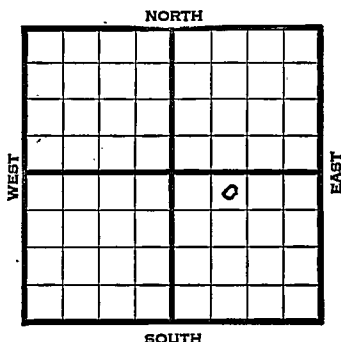

NE NW SE

1945

Elev. 1841

R E P O R T

~~4-4~~

Location

4/12

166' Run csg.

4/20

13" @ 156

Drlg. 1985

4/27

Drlg. 3345

5/9

Lans 3349

Simp 3693

Arb. 3746

TD 3790'

ABANDONED

Pool Name WildcatMap No. K47 Sec. 13 Twp. 23 R. 12WWell No. 1 C.B. HughesStanolind

Company

FIRST REPORT

Contractor

NE NW SE

SECTION PLAT

330


Ft. from N. Line

Ft. from S. Line

Ft. from E. Line

990

Ft. from W. Line

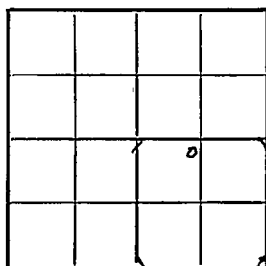StaffordLocation X

Rig up

Drilling and Remarks:

RECORD

Cased _____ in., _____ ft.

Sand _____

Gas _____

Oil _____

Total Depth _____

PRODUCTION

1st 24 hrs. Nat. _____

1st 24 hrs. after shot _____

Gas _____ Cu. Ft.

Dry Hole _____

Abandoned _____

Date

APR 4 1945 19

S. J. LEWIS

Scout


Kansas Pool Name WildcatMap No. 47 Sec. 13 Twp. 23 R. 12WWell No. 1 C.B. HughesStanolind

Company

ABANDONED

Contractor

NE NW SE

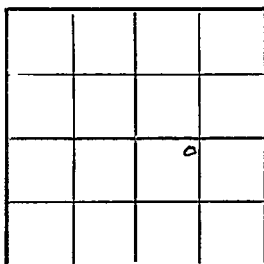E 11841
SECTION PLAT330 Ft. from N. Line Ft. from S. Line Ft. from E. Line990 Ft. from W. Line

Stafford County

Location Rig up

Drilling and Remarks:

Louis 3349Brig 3623Br 43746**RECORD**Cased in., ft.Sand Gas Oil Total Depth 3790**PRODUCTION**1st 24 hrs. Nat. 1st 24 hrs. after shot Gas Cu. Ft.Dry Hole Abandoned

Date

MAY 9 1945 19

S. J. LEWIS

Scout