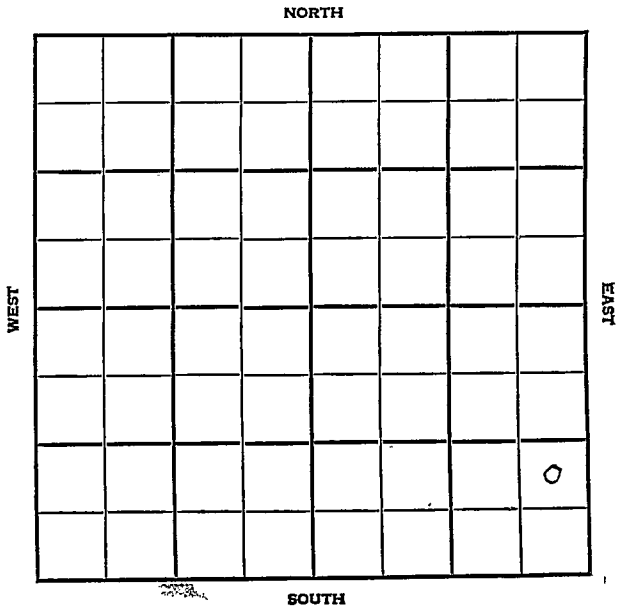


Section 13 Township 23 Range 11, WWell No. #2 T. A. MalinCompany Texas Co.

Stafford

KANSAS

SEC. 13	TWP. 23	R.. 14W
------------	------------	------------

WELL NO.

#2 T. A. Malin

FARM

COMPANY

Texas Company

CONTRACTOR

Stickle

Brenn


_____ Ft. from N. Line

_____ Ft. from S. Line

_____ Ft. from E. Line

_____ Ft. from W. Line

NE SE SE

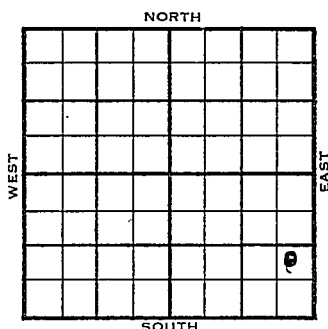

	ELEVATION	REPORT
1955	1919	

8/3 Comm. 7-28-55 **FIRST REPORT**
 10" @828 Drlg. 2669

8/31 Comm 7-28-55

H	3360	3359
BD	3500	3500
L	3516	3517
V	3868	2865
S	3926	3925
A	3990	3980
TD	4090	

10" @ 828

DST 3633-49 open 1 hr

Rec 30' OCM 120' oil 60' sw

958/20"

DST 3675-89 open 1 hr. Rec 110' sw

1280/30"

7" @ 4030 CO to 3993 20/3633-37

S/17 go 7 gw 2 hr 500 A S/73 bo

6% wtr 5 hr

Comp 140 bopd

COMPLETED

County **Stafford** Elev. _____
Sec. **13** Twp. **(23)** Rge. **14W**
Company **Texas Company**
FarmName **T. A. Malin** No. **2**

TOPS	DEPTH	LOG	DATUM
Anh.			
TP.			
H.			
Tr.			
Dg.			
BL.			
L.			
K.C.			
B.K.C.			
Ce.			
C.			
M.			
M.			
K.			
Mz.			
Me.			
V.			
S.			
S.			
A.			
R.			
Pe.			
G.			
T.D.			

Loc. in Sec. **NE SE SE**
Geol. _____
Contr. **Stickle**
Pool **Brenn**
FIRST REPORT
AUG 3 '55

Date Comm. **7-28-55**
10" @ 828 drlg. 2669

Handwritten signature

County Stafford Elev. 1919
 Sec. 13 Twp. 23 Rge. 14W
 Company Texas Company
 Farm Name T. A. Malin No. 2

TOPS	DEPTH	LOG	DATUM
Anh.			
Tr.			
H.	3360	3359	1440
Tr.			
Dg.			
BL.	2500	2500	1581
L.	3574	3517	1598
K.C.			
B.K.C.			
Ce.			
C.			
M.			
M.			
K.			
Mz.			
Mo.			
V.	3868	3865	1946
S.	3920	3925	2006
S.			
A.	3990	3980	2061
R.			
PE.			
G.			
T.D.	4090		

Loc. in Sec.

NE SE SE


Geol.

Contr.

Stickle

Pool

Brenn

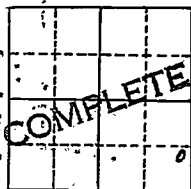Date Comm. 7-28-55 AUG 31 195510" @ 828 DS^T 3633-119 open 1 hr.Rec. 30' ocm 120' ocm 60' SW 958/20"DS^T 3675-89 open 1 hr. Rec. 110' SW3280/30" 7" @ 4030 GO to 399320/ 3633-37 S/ 17 go 7 gw 2 hr.500A S/ 73 bo 6% wtr. 5 hr.Comp. 140 bopd