

Section 13 Township 23 Range 16WWell No. 1 DoerrCompany W. B. Guyer

							0	

NORTH

WEST

EAST

SOUTH

Pawnee

KANSAS



Sec. 13 Twp. 23 R. 16 W

Well No. # 1 Doerr Farm

W. B. Guyer Company

Sterling Drlg. Contractor


 Ft. from N. Line

330 Ft. from S. Line

330 Ft. from E. Line

 Ft. from W. Line


SE SE NE

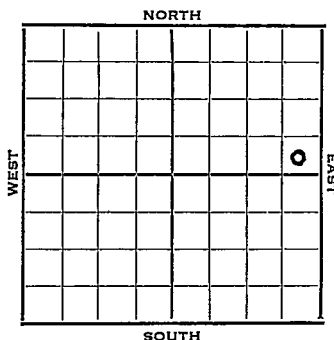

1953 Elev. 2038' REPORT

4/8 Location
4/16 8" @ 365'
Drlg 2843'
4/22 Spud 4-7-53
D&A
TD 4200
8" @ 365'
Heeb 3519, Br line 3648, Lans 3654
DST 3693-3703, opn 1 hr., rec 18' mud
1050#
DST 3803-17, opn 1 hr., rec. 120' sw =
1125#, Cong 4002
DST 4003-304, opn 1 hrs., rec. 40' mud
&SSO, 0#,
Viola 4084, Simp 4100, Arb. 4149
TD 4200
D&A

ABANDONED

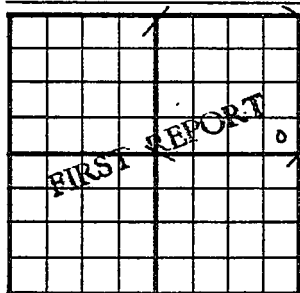County Pawnee State KansasSec. 13 (Blk. Twp.) 23 (Sur. Rge.) 16W Map No.Operator W. B. GuyerWell No. 1 Farm DoerrElev. Location SE SE NE330 Ft. From S Line NE330 Ft. From E Line Quarter1st. Report APR 8 1953

Completion

Remarks

Sterling Drlg. - Contr.

Spudding Date

Drlg. Data

Location


County Pawnee State Kansas

Sec. 13 (Blk. Twp.) 23 (Sur. Rge.) 16W Map No.

Operator W. B. Guyer

Well No. 1 Farm Doerr

Elev. 2038 Location SE SE NE

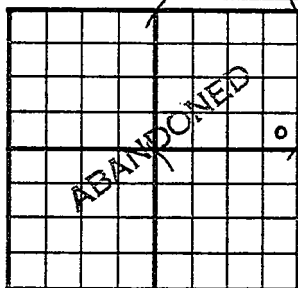

330Ft. From S Line NE

330Ft. From E Line Quarter

1st. Report

Completion APR 22 1953

Remarks

Sterling Drlg. - Contr.

Spudding Date 4-7-53

Drlg. Data D & A TD 4200

8" @ 365 Heeb. 3519 Br. lime 3648

Lans. 3654 DST 3693-3703 open 1 hr.

Rec. 18' mud 1050# DST 3803-17

open 1 hr. Rec. 120' sw 1125#

Cong. 4002 DST 4003-30 open 1 hr.

Rec. 40' mud & SSO 0# Viola 4084

Simp. 4100 Arb. 4149 TD 4200

D & A