


Finney

Section 13 Township 23 Range 34W **KANSAS**

Well No. #1 Bidwell

Company Champlin Ref.

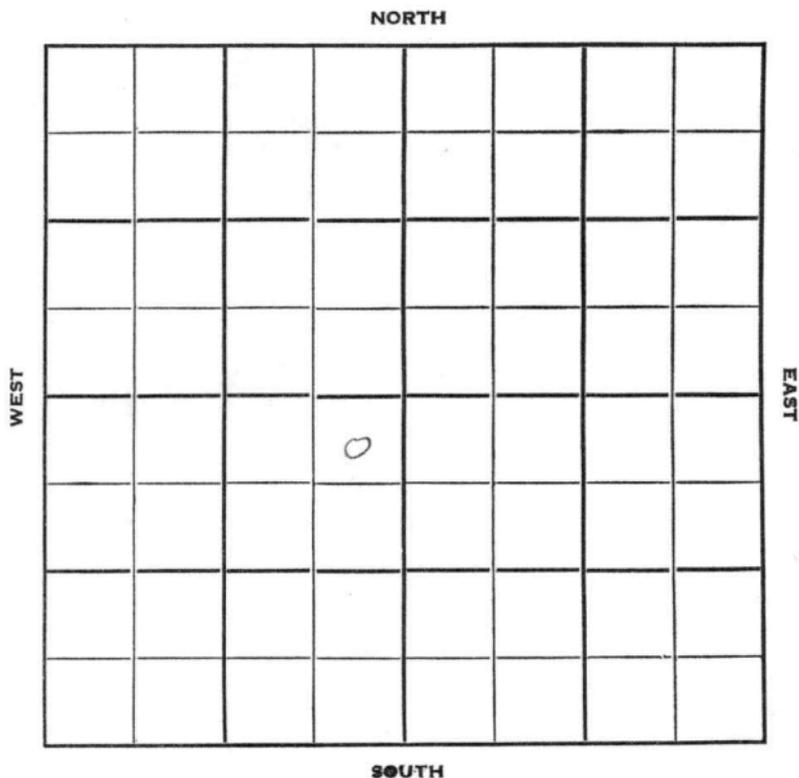

Sec. 13 Twp. 23 R. 34W

Well No. #1 Bidwell Farm

Champlin Ref. Company


Hugoton Pool Contractor

330' Ft. from N. Line

_____ Ft. from S. Line

330' Ft. from E. Line

_____ Ft. from W. Line

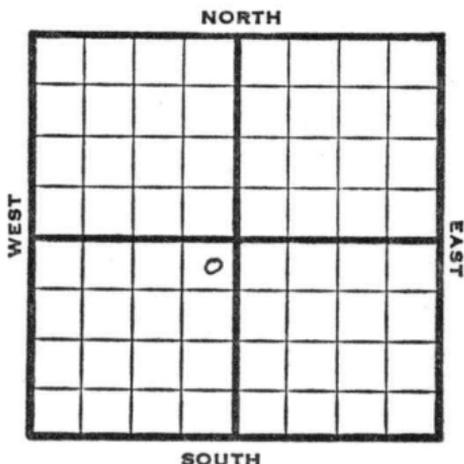

NE NE SW

1950 Elev. 2934' REPORT

11/29 Location

1951
3/21 Spud 12-27-50 Gas well TD 2625'
10" @ 340 Her. 2425', Krider 2466',
Win. 2515', Towanda 2579',
TD 2625' 7" @ 2625'
126/ 2594-2615', 60/ 2579-89', 2000 A
150/ 2540-50', 4000 A, 90/2481-96',
72/ 2466-78', 4000 A, SP 2448',
48/ 2435-43, 23,000 A
Comp. 1,768,000 gas 416#

COMPLETED

