


FORM 51

Section 13 Township 23 Range 37WWell No. #1 BurnetteCompany Kansas-Nebraska

NORTH

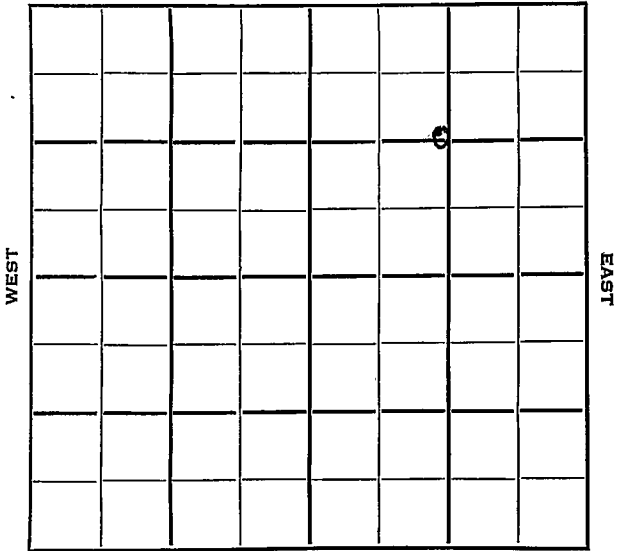

SOUTH

HOT FILE Kearny

KANSAS

SEC.

TWP.

R.

13

23

37 W

WELL NO.

1 Burnette

FARM

COMPANY

Kansas-Nebraska

CONTRACTOR

Hugoton Pool

NORTH

1320

Ft. from N. Line

Ft. from S. Line

1320

Ft. from E. Line

Ft. from W. Line

C NE/4

SOUTH

ELEVATION

REPORT

1954

3221'

4/14

Spud 4-12-54
8" @ 330 WOC

5/5

RTD 2766'
5" @ 2765
WOCT.

5/12

Her. Kr. 2565', Win 2619', Tow
2680', Ft. Riley 2722'

5/19

CO 60/ 2724-34 1000 A SSG / 25
gwph sq. 156/ 2566-92 150/ 2619-
44 120/ 2682-2702 frac. 3000 A
1500 A 1500 A


5/26

Spud 4-12-54 Gas well TD 2766
8" @ 330 Her. 2565 Win. 2619
Tow. 2680 Ft. Riley 2722 TD 2766
5" @ 2765 CO 60/2724-34 1000 A
SSG 25 GWPH 156/2566-92 150/2619-
44. 120/2682-2702 dol-frac.
3000 gal. 2666-92 1500 A 2619-44
1500 A 2682-2702 1,645,000 gas.
3000 A Comp. 1,645,000 gas.

COMPLETED

J. G. McGEHEE

County Kearny State Kansas
 Sec. 13 (Blk. 23) (Sur. 37W) Map No. 13
 Operator Kansas-Nebraska
 Well No. 1 Farm Burnette
 Elev. 3221 Location C NE/4

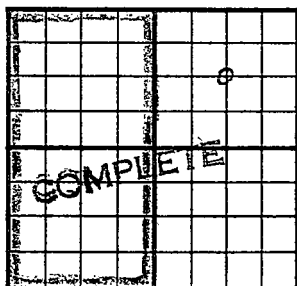

1320 Ft. From N Line NE
 1320 Ft. From E Line Quarter

1st. Report

Completion MAY 26 1954

Remarks Hugoton Pool

Spudding Date 4-12-54

Drig. Data Gas well TD 2766

8" @ 330 Her. 2565 Win. 2619

Tow. 2680 Ft. Riley 2722 TD 2766

5" @ 2765 CO 60/ 2724-34 1000 A

SSG 25 gwph 156/ 2566-92 150/ 2619-44

120/ 2682-2702 dol-frac 3000 gal.

2666-92 1500 A 2619-44 1500 A 2682-2702

1,645,000 gas 3000 A

Comp. 1,645,000 gas

J. G. McGEHEE