

KANSAS

Harvey

Section 14 Township 23 Range 1W

Well No. 1 Hupp

Company Dorsey S. Hager

Wildcat

NORTH

WEST

EAST

SOUTH

0

Harvey KANSAS

Sec. 14 Twp. 23 R. 1W ✓

Well No. #1 Hupp Farm

Dorsey S. Hager Company

Wildcat (Shawver-Graham, Cont. NORTH


990' Ft. from N. Line

Ft. from S. Line

990' Ft. from E. Line

Ft. from W. Line

SW NE SE

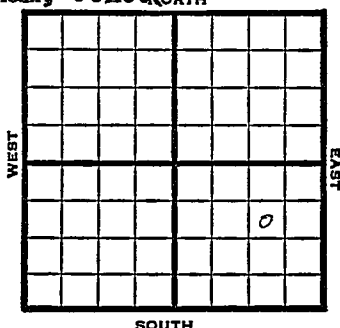

1949

Elv 1452'

REPORT

8/10

8" @ 185'

Drlg. 2314'

8/17

Lansing 2310'

KC 2638'

Miss 3024'

Hunton 3420'

Drlg. 3450'

8/24

TD 3591'

Viola 3440'

Simp 3537'

Aband.

ABANDONED

Kansas

Map No. _____ Sec. 14 Twp. 23 R. 1WWell No. 1 Hupp

_____ Dorsey S. Hager _____ Company

_____ Shawver - Graham _____ Contractor


SW NE SE

FIRST REPORT
SECTION PLAT990 Ft. from N. Line

_____ Ft. from S. Line

990 Ft. from E. Line

_____ Ft. from W. Line

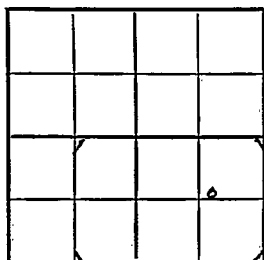

Harvey County

Location _____

Rig up _____

Drilling and Remarks:

8" @ 185

drlg. 2314

RECORD

Cased _____ in., _____ ft.

Sand _____

Gas _____

Oil _____

Total Depth _____

PRODUCTION

1st 24 hrs. Nat. _____

1st 24 hrs. after shot _____

Gas _____ Cu. Ft.

Dry Hole _____

Abandoned _____

Date

AUG 10 1949

19

S. J. LEWIS

Scout

Kansas

Map No. K39 Sec. 14 Twp. 23 R. 1WWell No. 1 Hupp

Dorsey S. Hager

Company

ABANDONED

Contractor

SW NE SE

E11/1452
SECTION PLAT990 Ft. from N. Line Ft. from S. Line990 Ft. from E. Line Ft. from W. Line

			0

Harvey County

Location Rig up

Drilling and Remarks:

Vis 2440Swing 2537**RECORD**Cased in., ft.Sand Gas Oil Total Depth 2591**PRODUCTION**1st 24 hrs. Nat. 1st 24 hrs. after shot Gas Cu. Ft.Dry Hole Abandoned

Date

AUG 24 1949

19

S. J. LEWIS

Scout