

Map No. KANSAS Sec. 14 Twp. 23 R. 4^w

Well No. 1 Downie Farm Alsen & Shell Company

Reno

NORTH


WEST

EAST

SOUTH

O. W. D. D.

7

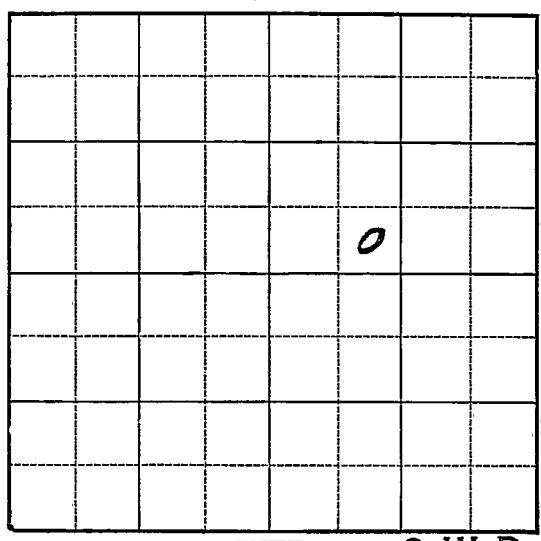

Location _____
Drilling Remarks _____

Rig Up _____
Drilling Remarks _____

RECORD

Cased _____ in. _____ ft.
Sand _____
Gas _____
Oil _____
Total Depth _____

PRODUCTION

1st 24 hrs. Nat. _____
1st 24 hrs. after shot _____
Gas _____ cu. ft. _____
Dry Hole _____
Abandoned _____

_____ Ft. from N. Line

330 Ft. from S. Line

_____ Ft. from E. Line

990 Ft. from W. Line

NORTH

WEST EAST

SOUTH

Date 1934 REPORT O. W. D. D.

9/19 Location
9/27 Rign up.
10/4 Alg 700 15 1/2 160.
10/11 " 2375
10/18 " 3190
10/25 Chat 3248 B3ML 3480
Huntton 3589 T1 3592
Core 3589-905.0. 8" 3587 Rust
11/1 3596 HFO. 3 hrs flo at 3597
11/8 3604 flow 1376 Bbls.
11/14 Huntton 3589 T1 3604
1376 Bbls before acid
1000 acid
flow 5224 Bbls.

COMPLETED

O. W. D. D

1938	O. W. D. D
6/29	Dlg. 3652 salt wtr. disposal
7/8	Viola 3694-3721'. Wilcox 3723' S. O. T. D. 3727'. Rng. 7".

OVER

1938

7/15 Drilled plug. Pumped 360 oil &
94 wtr. in 23 hrs.

7/22 Pump 44 oil in 8 hrs.

7/27 7" - 3714'.
Wilcox 3723'.
T. D. 3727'.
Potential 126 bbls.

COMPLETED

KANSAS

Map No. 40 Sec. 14 Twp. 23 R. 4WWell No. 1- DownieOlsen & Shell Company

Contractor

SECTION PLAT

		0	

Ft. from N. Line

330 Ft. from S. Line

Ft. from E. Line

990 Ft. from W. Line

FIRST REPORTS

Location ✓

Rig up

Drilling and Remarks:

RECORD

Cased _____ in., _____ ft.

Sand _____

Gas _____

Oil _____

Total Depth _____

PRODUCTION

1st 24 hrs. Nat. _____

1st 24 hrs. after shot _____

Gas _____ Cu. Ft.

Dry Hole _____

Abandoned _____

Date

9-19-34₁₉

EVAL MANNSCHRECK

Scout

Map No. 40 Sec. 14 Twp. 23 R. 4WWell No. 1 - DownieOlsen & Shell Company

Contractor

COMPLETED

SECTION PLAT

		0	

Ft. from N. Line

330 Ft. from S. Line

Ft. from E. Line

990 Ft. from W. Line

Location

Rig up

Drilling and Remarks:

1376 bbls
before and
1000 and
flow
5224
bbls

RECORD

Cased _____ in., _____ ft.

Sand Hutton 3589

Gas _____

Oil _____

Total Depth 3604

PRODUCTION

1st 24 hrs. Nat. _____

1st 24 hrs. after shot _____

Gas _____ Cu. Ft.

Dry Hole _____

Abandoned _____

Date

11-14-34 192

ORVAL MANNSCHRECK Scout

Reno

KANSAS

Map No. Sec. 14 Twp. 23 R. 4WWell No. 1 E. K. DownieOlson Drilling Company

Contractor

FIRST REPORT

SE SW NE

SECTION PLAT

 Ft. from N. Line330 Ft. from S. Line Ft. from E. Line990 Ft. from W. LineLocation

RECORD

Cased in., ft.Sand Gas Oil Total Depth

PRODUCTION

1st 24 hrs. Nat. 1st 24 hrs. after shot Gas Cu. Ft.Dry Hole Abandoned

Drilling and Remarks:

OWDD-OTD 3603

Old Poten 5461

Hunton 3589-3625

Dr1g. 3652 SWD

501 TW
dispos

Date

JUN 29 1938 19 H. D. Hatfield Scout

Reno KANSAS

Map No. 40 Sec. 14 Twp. 23 R. 4WWell No. 1 E. K. DownieOlson Drlg.

Company

Contractor

COMPLETED

SE SW NE

Ft. from N. Line

330 Ft. from S. Line

Ft. from E. Line

990 Ft. from W. Line

SECTION PLAT

		0	

Location

Rig up

Drilling and Remarks:

RECORD

Cased 7 in., 3714 ft.Sand W. Cox 3723

Gas

Oil

Total Depth 3727

PRODUCTION

1st 24 hrs. Nat.

1st 24 hrs. after shot

Gas Cu. Ft.

Dry Hole

Abandoned

Date

JUL 27 1938

19

H. D. Hatfield

Scout