

Map No. KANSAS Sec. 14 Twp. 23 R. 4a
Well No. 3 Downie Farm
Olson & Shell Company

NORTH

WEST

EAST

SOUTH

Location_____

Drilling Remarks

Rig Up-----
Drilling Remarks

RECORD

Cased _____ in. _____ ft.
 Sand _____
 Gas _____
 Oil _____
 Total Depth _____


PRODUCTION

1st 24 hrs. Nat. _____
1st 24 hrs. after shot _____
Gas _____ cu. ft. _____
Dry Hole _____
Abandoned _____

Reno

Map No. KANSAS Sec. 14 Twp. 23 R. 4W
Well No. 3 Novice Farm
Olsen & Shell Company

 Ft. from N. Line
330 Ft. from S. Line
 Ft. from E. Line
330 Ft. from W. Line

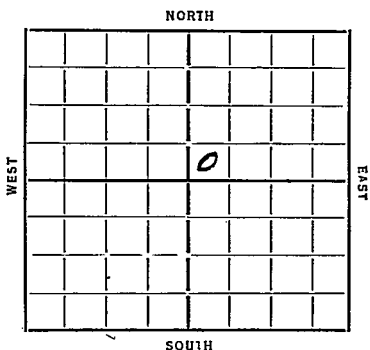

Date	REPORT
1934	
11/27	Moving in
12/6	Rign
12/13	Qty 485 12 1/2 253
12/21	" 1441 10" 540
12/27	" 2805
1/3/35	" 2930
1/10	" 3220
1/17	" 3429 Chit 3253
1/24	Miscner 3594 7" 3595 Rust
1/31	Hutton 3597 T 3606
	2468 Bbls Net. Acidizing
2/6	Hutton 3597 T 3606
	1000 acid 4789 Bbls.

COMPLETED

KANSAS

Map No. 40 Sec. 14 Twp. 23 R. 4WWell No. 3-DownieOlsen & Shell Company

Contractor

FIRST REPORT

SECTION PLAT

Ft. from N. Line

330 Ft. from S. Line

Ft. from E. Line

330 Ft. from W. Line

		0	

Location

Rig up

Drilling and Remarks:

Moving in

RECORD

Cased _____ in., _____ ft.

Sand _____

Gas _____

Oil _____

Total Depth _____

PRODUCTION

1st 24 hrs. Nat. _____

1st 24 hrs. after shot _____

Gas _____ Cu. Ft.

Dry Hole _____

Abandoned _____

Date

ORVAL MANNSCHRECK

11-27-34 192

Scout

Map No. 40 Sec. 14 Twp. 23 R. 4WWell No. 3-DownieOlsen & Shell Company

Contractor

COMPLETED

SECTION PLAT

		0	
		1	

Ft. from N. Line

330 Ft. from S. Line

Ft. from E. Line

330 Ft. from W. Line

Location.....

Rig up.....

Drilling and Remarks:

1000 acid4789 bbls

RECORD

Cased.....in.,.....ft.

Sand Huntton 3597

Gas.....

Oil.....

Total Depth 3606

PRODUCTION

1st 24 hrs. Nat.....

1st 24 hrs. after shot.....

Gas.....Cu. Ft.

Dry Hole.....

Abandoned.....

Date

ORVAL MANNSCHRECK

2-6-34 192.....

Scout