


Map No. **KANSAS** Sec. 14 Twp. 23 R. 4W
 Well No. 5 Downie Farm
Olsen & Shell Company

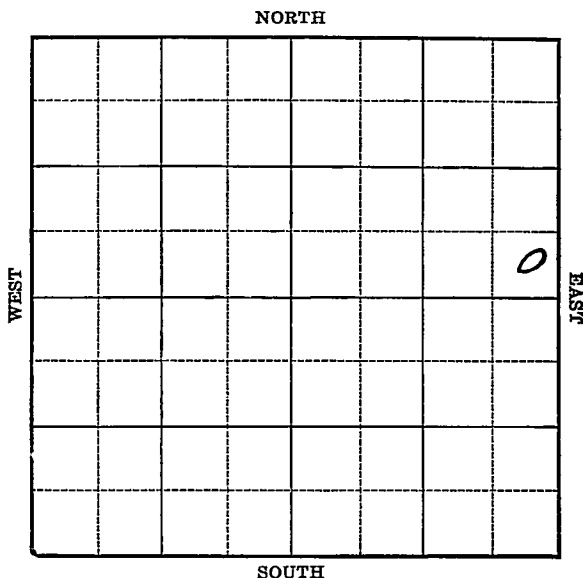

Location _____
 Drilling Remarks _____

Rig Up _____
 Drilling Remarks _____

RECORD

Cased _____ in. _____ ft.
 Sand _____
 Gas _____
 Oil _____
 Total Depth _____

PRODUCTION


1st 24 hrs. Nat. _____
 1st 24 hrs. after shot _____
 Gas _____ cu. ft.
 Dry Hole _____
 Abandoned _____

Reno

Map No. KANSAS Sec. 14 Twp. 23 R. 4^W

Well No. 5 Downie Farm
Olsen & Shell Company

 Ft. from N. Line
330 Ft. from S. Line
330 Ft. from E. Line
 Ft. from W. Line

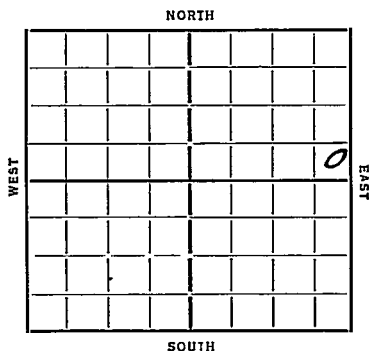

REPORT	
12/5	Location
12/13	Rig
12/21	Dlg 1163 15 1/2 250
12/27	" 2864
1/3/35	Chit 3262 7 sq. 3599
1/10	BML 3487 Hutton 3595
	7" 3593 Rust
1/17	
1/24	Hutton 3599 Connected
	50 x W 3601-02 HFW 3607
	Rem 5"
1/31	5" 3610
2/7	Dlg 3612
2/14	" 3682 5" 3632
2/21	B. Hutton 3632 Vista 3708
	WX 3737 HFW 3741-42
2/28	Silicious 3822 UR 5"
3/7	5" 3820
3/14	1000' Water Coring 3882
3/21	3837 P.B.
3/28	5' M Gas & 50 x W.

(OVER)

4/3 Hutton 3599
Siliceous 3822
PB 3370
Rip pipe
10 M Lss.

COMPLETED

Map No. 40 Sec. 14 Twp. 23 R. 4WWell No. 5 - DownieOlsen & Shell Company

Contractor

FIRST REPORTS

SECTION PLAT

.....Ft. from N. Line

330 Ft. from S. Line330 Ft. from E. Line

.....Ft. from W. Line

			0

Location ✓

Rig up.....

Drilling and Remarks:

RECORD

Cased.....in.,ft.

Sand.....

Gas.....

Oil.....

Total Depth.....

PRODUCTION

1st 24 hrs. Nat.....

1st 24 hrs. after shot.....

Gas.....Cu. Ft.

Dry Hole.....

Abandoned.....

Date

ORVAL MANNSCHRECK

12-5-37 192.....Scout

Map No. 40 Sec. 14 Twp. 23 R. 4WWell No. 5-DownieOlsen & Shell Company

Contractor

COMPLETED

SECTION PLAT

			0

Ft. from N. Line

330 Ft. from S. Line330 Ft. from E. Line

Ft. from W. Line

Location

Rig up

Drilling and Remarks:

PB 3370
Rip pipe
10 m 900

RECORD

Cased _____ in. _____ ft.

Sand Hutton 3599Gas silicon 3822

Oil _____

Total Depth _____

PRODUCTION

1st 24 hrs. Nat. _____

1st 24 hrs. after shot _____

Gas _____ Cu. Ft.

Dry Hole _____

Abandoned _____

Date

4-3-35 192

ORVAL MANNSCHRECK

Scout