

Section 14 Township 23 Range 4 WWell No. # 1 HensleyCompany Wilson & Short

NORTH

					0		

WEST

EAST

SOUTH

10

Reno KANSAS

SEC.	TWP.	R.
14	23	4W

WELL NO.

I Hensley

FARM

COMPANY

Wilson & Short

CONTRACTOR

Badger


Burrton Pool

990 Ft. from N. Line

Ft. from S. Line

Ft. from E. Line

990 Ft. from W. Line

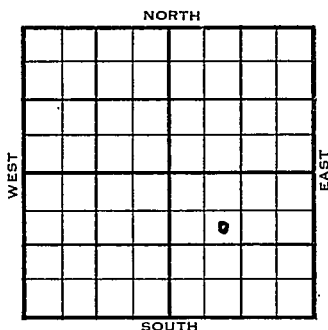

SE NW SE

	ELEVATION	REPORT
1955	1471'	

2/16

Spud 2-13-55
8" @ 254', WOC

4/13

Spud 2-13-55 - Temp. Aban.

TD 3603'

8" @ 254'

Miss. 3245'

DST 3319-60', opn 50", rec. 35' mud,
off

Kh. 3475', Hunton 3588'

TD 3590'

5" @ 3588'

DD 3592', 250A

S/70 bo 500 bw 6 hrs.

DD 3603 wtr


PB 3595'

S/2 bfph

Temp. abd.

ABANDONED

County **Reno** State **Kansas**
 Sec. **14** (Blk. Twp.) **23** (Sur. Rge.) **4W** Map No.
 Operator **Wilson & Short**
 Well No. **1** Farm **Hensley**
 Elev. Location **SE NW SE**

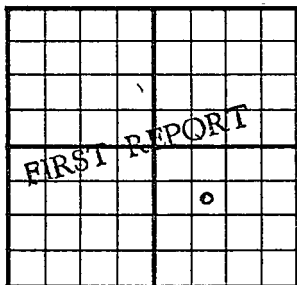

990 Ft. From **N** Line **SE**

990 Ft. From **W** Line Quarter

1st. Report **FEB 1 6 1955**

Completion

Remarks

Badger - Contr.

Spudding Date **2-13-55**


Drlg. Data

Burrton Pool

8" @ 254 WOC

FABEN GILSTRAP

County Reno State Kansas
 Sec. 14 (Blk.) 23 (Sur.) 4W Map No.
 Operator Wilson & Short
 Well No. 1 Farm Hensley
 Elev. 1471 Location SE NW SE

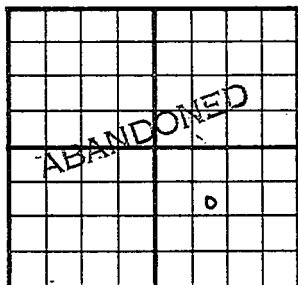

990 Ft. From N Line SE

990 Ft. From W Line Quarter

1st. Report

Completion APR 13 1955

Remarks Burrton PoolBadger - Contr.Spudding Date 2-13-55

Drlg. Data Temp. abd. TD 3603

8" @ 254 Miss. 3245 DST 3319-60

open 50 min. Rec. 35' mud 0#

Kh. 3475 Hunton 3588 TD 3590

5" @ 3588 DD 3592 250 A S/ 70 bo

500 bw 6 hr. DD 3596 P/ 50 bo

500 bwpd DD 3603 wtr. PB 3595

S/ 2 bfph Temp. abd.

FABEN GILSTRAP