

KANSAS

Reno

FORM 51 5M 1-42 PETROL

Section 14 Township 23 Range 10-W

Well No. #3 Crandall

Company Sinclair-Prairie

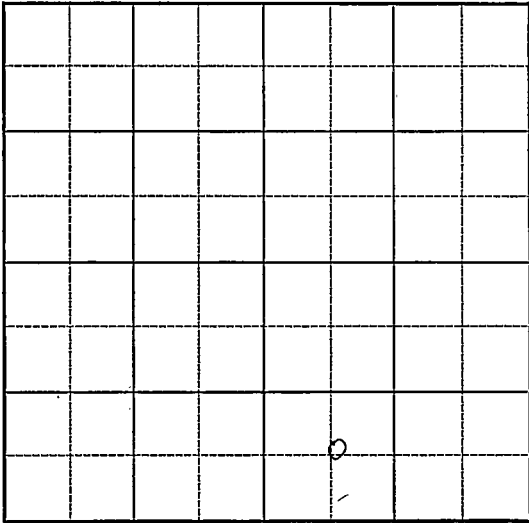
Peace Creek Pool

NORTH

WEST

EAST

SOUTH

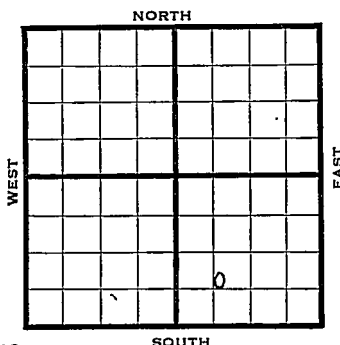


KANSAS

Reno

Sec. 14 Twp. 23 R. 10-WWell No. #3 Grandell FarmSinclair Prairie Company

Peace Creek Pool

 Ft. from N. Line766 Ft. from S. Line Ft. from E. Line766 Ft. from W. Line

C SW SE Elev. 1759

1942

REPORT

11/18 Derrick
11/24 8" @ 293 WOC
12/2 Drlg. 2440
12/9 Drlg 3510
12/16 Lans 3258
Miss 3583 Kind 3636
Viola 8754
TD 3758
5" @ 3756 rust.
12/22 TD 3770' 2600' Oil
12/29 500 acid pump 328 oil 19 hrs.
1943
1/6 Viola 3754 5" - 3756
500 acid
Bomb Pot. 3128
Max 3000
T.D. 3770
Gravity 42.

COMPLETED

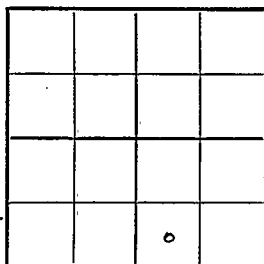
Reno

KANSAS

Map No. 47 Sec. 14 Twp. 23 R. 10WWell No. 3 CrandellSinclair-Prairie CompanyFIRST REPORT Contractor

C SW SE

SECTION PLAT

 Ft. from N. Line766 Ft. from S. Line Ft. from E. Line766 Ft. from W. Line

PEACE CREEK POOL

Location Rig up

Drilling and Remarks:

Derrick

RECORD

Cased in., ft.Sand Gas Oil Total Depth

PRODUCTION

1st 24 hrs. Nat. 1st 24 hrs. after shot Gas Cu. Ft.Dry Hole Abandoned

Date

NOV 18 1942 19 S. J. LEWIS Scout

Ren o

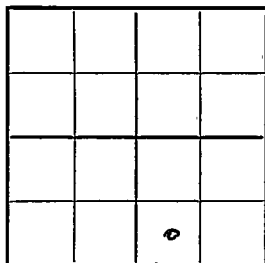
KANSASMap No. 47 Sec. 14 Twp. 23 R. 10WWell No. 3 CrandellSinclair-Prairie

Company

COMPLETED

Contractor

C SW SE

SECTION PLAT

_____ Ft. from N. Line

766 Ft. from S. Line

_____ Ft. from E. Line

766 Ft. from W. Line**PEACE CREEK POOL**

Location _____

Rig up _____

Drilling and Remarks:

Vista 3754
5" @ 3756
500 cu. ft.
Box 402 3128
Max 3000

42 @ 300

RECORD

Cased _____ in., _____ ft.

Sand _____

Gas _____

Oil _____

Total Depth 3220**PRODUCTION**

1st 24 hrs. Nat. _____

1st 24 hrs. after shot _____

Gas _____ Cu. Ft.

Dry Hole _____

Abandoned _____

Date

JAN 6 1943 19S. I. LEWIS Scout