

KANSAS

FORM 51 5M 10-41 PETROL


Reno

Section 14 Township 23 Range 10-W

Well No. #1 C. C. Crandall

Company Sinclair-Prairie

NORTH Peace Creek Pool

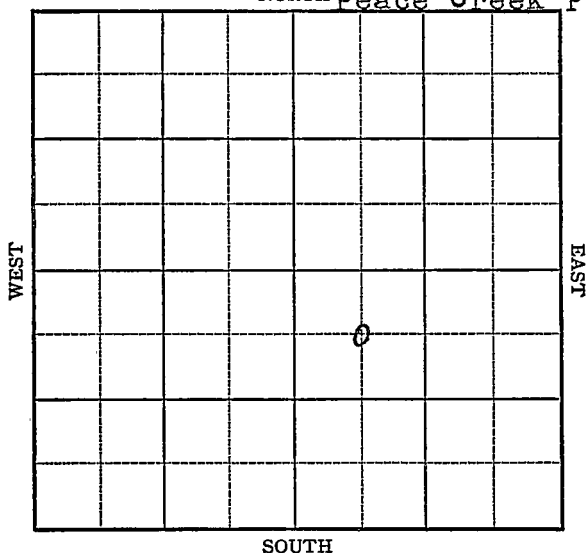

Sec. 14 Twp. 23 R. 10-W

Well No. #1 C. C. Crandall Farm

Sinclair-Prairie Company

(Peace Creek)

660

Ft. from N. Line


Ft. from S. Line

Ft. from E. Line

660

Ft. from W. Line

Elev. 1761

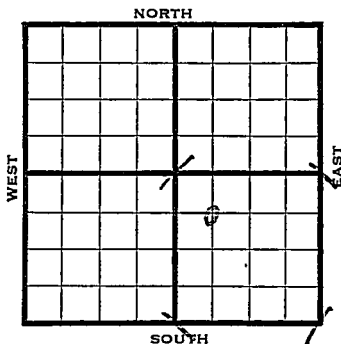

1942

REPORT

7/1 Cellar & Pits.
7/8 Derrick.
7/15 Drlg. 1000'
7/22 8" - 290' Drlg. 2965'
7/29 Viola ³⁷⁶⁰~~3739~~ 5" - 3760 RUST
8/5 Viola 3760(corrected)
5" - 3762
T.D. 3767-200' oil 1/2 hr.
8/12 Viola 3760
5" - 3762
T.D. 3767
3000 acid
Bomb Pot. 5435
Max. 3000
Gravity 42.

COMPLETED

Reno

KANSAS

Map No. 47 Sec. 14 Twp. 23 R. 10WWell No. 1 C. C. Crandall

Sinclair-Prairie


Company

FIRST REPORT

Contractor

SECTION PLAT

C NW SE

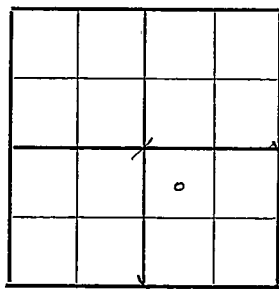660 Ft. from N. Line Ft. from S. Line Ft. from E. Line660 Ft. from W. Line

PEACE CREEK POOL

Location Rig up

Drilling and Remarks:

Cellar and Pits

RECORD

Cased in., ft.Sand Gas Oil Total Depth

PRODUCTION

1st 24 hrs. Nat. 1st 24 hrs. after shot Gas Cu. Ft.Dry Hole Abandoned

Date

JUL 1 1942

19

S. J. LEWIS

Scout

Map No. 47 Sec. 14 Twp. 23 R. 10WWell No. 1 C. C. CrandallSinclair-Prairie

Company

COMPLETED

Contractor

SECTION PLAT

C NW SE

660 Ft. from N. Line Ft. from S. Line Ft. from E. Line660 Ft. from W. Line

PEACE CREEK POOL

		o	

Location Rig up

Drilling and Remarks:

*Vista 3760**5" @ 3762**3000 cu ft**Born & Pat 435**Waf 3000**4200 ft*

RECORD

Cased in., ft.Sand Gas Oil Total Depth 3767

PRODUCTION

1st 24 hrs. Nat. 1st 24 hrs. after shot Gas Cu. Ft.Dry Hole Abandoned

Date

AUG 12 1942

19

S. J. LEWIS Scout