


Reno

Section 14 Township 23 Range 10-W

Well No. #1 Endicott

Company Cities Service Oil
Peace Creek Pool

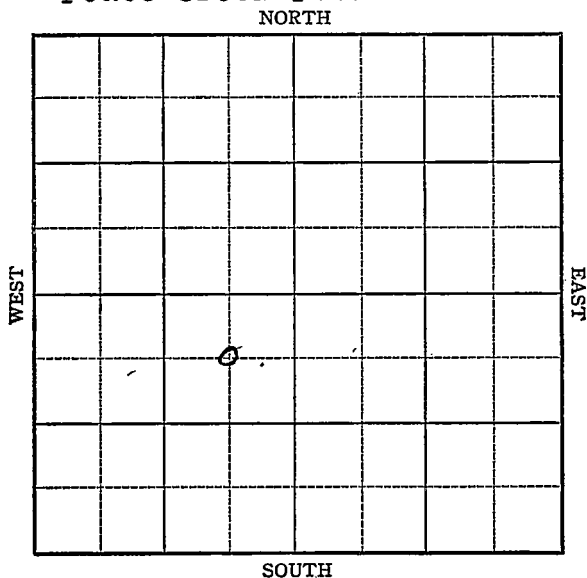

KANSAS Reno

Sec. 14 Twp. 23 R. 10-W

Well No. #1 Endicott Farm

Cities Service Oil Company

(Peace Creek Pool)


660 Ft. from N. Line

Ft. from S. Line

660 Ft. from E. Line

Ft. from W. Line

Elev. 1763

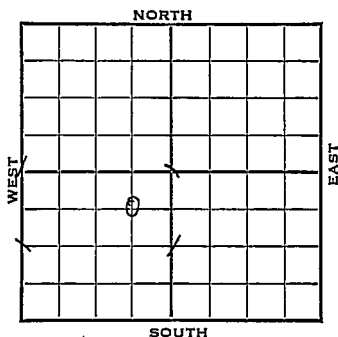

1942

REPORT

8/27

Location

9/2

8" - 156' Drlg. 1777

9/9

Drlg. 3618

9/16

Lans 3264 Miss 3591

Kind 3628, Viola ~~5762-33~~ 3766

TD 5" @ ³⁷⁶⁸~~3765~~ Rust.

9/23

TD ³⁷⁷³~~3775~~ flow 1 oil per hr 4 hrs.

9/30

TD 3773 SLM corrected

5" - 3769-Corr. Viola 3766(Corr)

Pumped 115 bo 8 hours

10/7

Viola 3766

5" - 3769

3000 acid

Bomb Pot. 2940

T.D. 3773

Gravity 42.

COMPLETED

Map No. 47 Sec. 14 Twp. 23 R. 10WWell No. 1 Endicott

Cities Service Oil

Company

FIRST REPORT

Contractor

C NE SW


660 Ft. from N. Line

Ft. from S. Line

660 Ft. from E. Line

Ft. from W. Line

SECTION PLAT

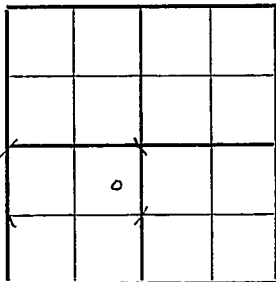

PEACE CREEK POOL

Location XXX

Rig up

Drilling and Remarks:

RECORD

Cased _____ in., _____ ft.

Sand _____

Gas _____

Oil _____

Total Depth _____

PRODUCTION

1st 24 hrs. Nat. _____

1st 24 hrs. after shot _____

Gas _____ Cu. Ft.

Dry Hole _____

Abandoned _____

Date

AUG 27 1942 19S. J. LEWIS

Scout

Map No. 47 Sec. 14 Twp. 23 R. 10WWell No. 1 Endicott

Cities Service Oil


Company

COMPLETED

Contractor

C NE SW

SECTION PLAT

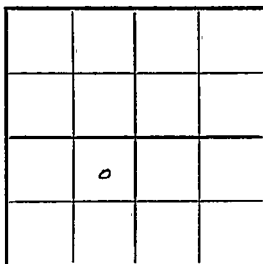660 Ft. from N. Line Ft. from S. Line660 Ft. from E. Line Ft. from W. Line

PEACE CREEK POOL

Location Rig up

Drilling and Remarks:

*Vila 3766**5" @ 3769**3000 acid**Bonus & P&S 2940**42° Gr*

RECORD

Cased in., ft.Sand Gas Oil Total Depth 3923

PRODUCTION

1st 24 hrs. Nat. 1st 24 hrs. after shot Gas Cu. Ft.Dry Hole Abandoned

Date

OCT 7 1942

19

S. J. LEWIS Scout