

# KANSAS

Reno


FORM 51 5M 4-41 PETROL

Section 14 Township 23 Range 10-W

Well No. #3 Sentney

Company Cities Service Oil

NORTH Peace Creek Pool

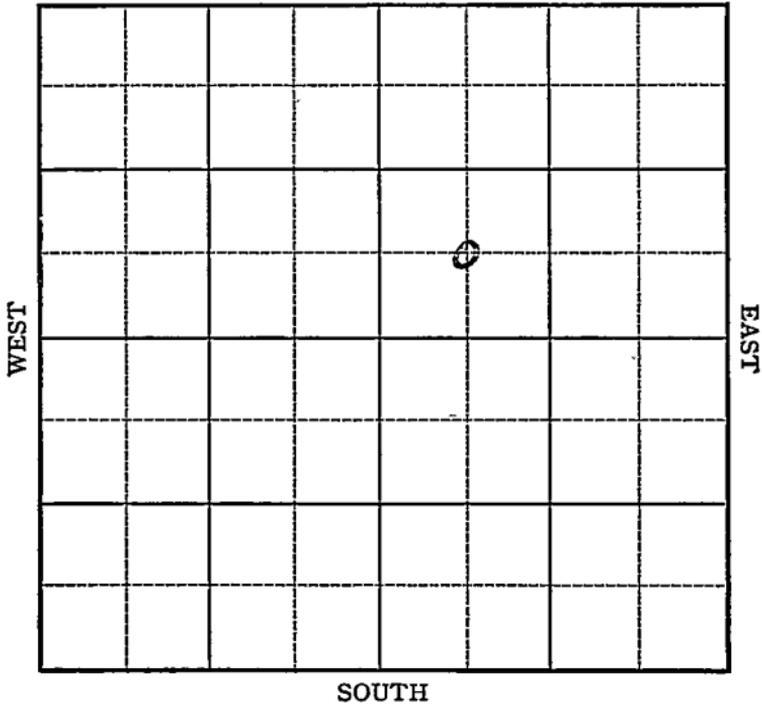



Map No. 47 Sec. 14 Twp. 23 R. 10WWell No. 3 Sentrey

Cities Service Oil Company

**FIRST REPORT**

Contractor

C S W N E

## SECTION PLAT

\_\_\_\_\_ Ft. from N. Line

600 Ft. from S. Line

\_\_\_\_\_ Ft. from E. Line

660 Ft. from W. Line

		o	

## PEACE CREEK POOL

Location \_\_\_\_\_

Rig up \_\_\_\_\_

Drilling and Remarks:

8" - 257'

Drlg. 2237'

## RECORD

Cased \_\_\_\_\_ in., \_\_\_\_\_ ft.

Sand \_\_\_\_\_

Gas \_\_\_\_\_

Oil \_\_\_\_\_

Total Depth \_\_\_\_\_

## PRODUCTION

1st 24 hrs. Nat. \_\_\_\_\_

1st 24 hrs. after shot \_\_\_\_\_

Gas \_\_\_\_\_ Cu. Ft.

Dry Hole \_\_\_\_\_

Abandoned \_\_\_\_\_

Date

JUN 17 1942

19

S. J. LEWIS Scout

Reno KANSAS

Map No. 47 Sec. 14 Twp. 23 R. 10W

Well No. 3 Sentney

Cities Service Oil Company

**COMPLETED**

Contractor

C S W N E

SECTION PLAT

\_\_\_\_\_ Ft. from N. Line

660 Ft. from S. Line

\_\_\_\_\_ Ft. from E. Line

660 Ft. from W. Line

		o	

PEACE CREEK POOL

Location \_\_\_\_\_

Rig up \_\_\_\_\_

Drilling and Remarks:

*Viola 3744*  
*5 "C 3751*  
*Com J P 3800*

*42°/62*

RECORD

Cased \_\_\_\_\_ in., \_\_\_\_\_ ft.

Sand \_\_\_\_\_

Gas \_\_\_\_\_

Oil \_\_\_\_\_

Total Depth 3762

PRODUCTION

1st 24 hrs. Nat. \_\_\_\_\_

1st 24 hrs. after shot \_\_\_\_\_

Gas \_\_\_\_\_ Cu. Ft.

Dry Hole \_\_\_\_\_

Abandoned \_\_\_\_\_

Date

JUL 15 1942 19

S. J. LEWIS Scout