


Section 14 Township 23 Range 12WWell No. #1 TholeCompany F. E. Lockhart

NORTH

WEST

EAST

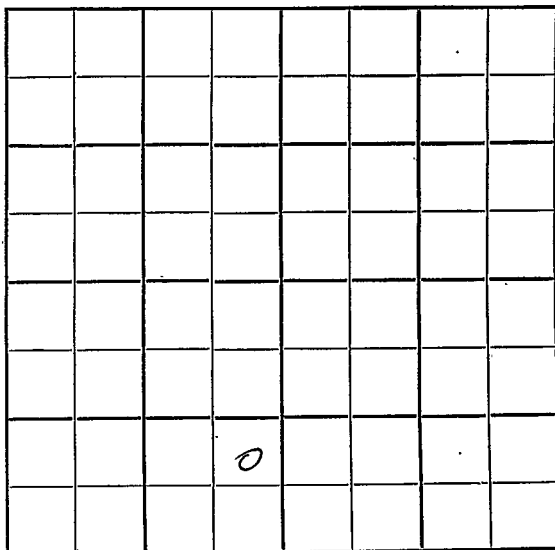

SOUTH

Stafford

KANSAS

Sec. 14 Twp. 23 R. 12W ✓

Well No. #1 Thole Farm

F. E. Lockhart Company

Veeder -Contr. Contractor


Wildcat

 Ft. from N. Line

990' Ft. from S. Line

330' Ft. from E. Line

 Ft. from W. Line

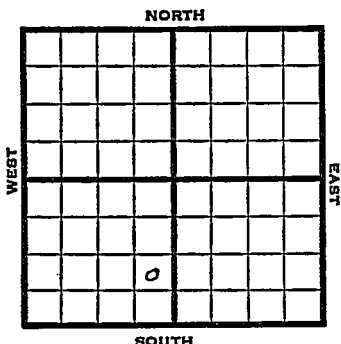

NE SE SW

1951 Elev. 1847' REPORT

6/20 Spud 6-15-51

8" @ 278

Anhy 940

Drlg. 1882'

7/3 Spud 6-15-51

D&A TD 3885

8" @ 278

Anhy 940 Lans. 3374

DST 3383-95 opn 45 min.

Rec. 30' mud

DST 3511-25 opn 1 hr Rec. 20' mud

Cong. 3694 Viola 3708

Simp 3750

DST 3711-53 opn 1/2 hr Rec. 30' mud

Arb 3809 TD 3885

D&A

ABANDONED

County Stafford State Kansas

Sec. **14** (Blk. Twp.) **23** (Sur. Rge.) **12W** Map No.

Operator E. E. Lockhart

Well No. **1** Farm **Trile**

Elev.	Location	NE	SE	SW	W

FIRST REPORT

990 Ft. From S Line SW

FIRST REPORT 330 Ft. From E Line Quarter;

1st. Report **JUN 20 1951**

Completion

Remarks

Veeder - Contr.


Spudding Date **6-15-51**

Drlg. Data Wildcat

8ⁿ @ 278: Anby 940 Dr 1^o. 1882

J. E. TYRA

County Stafford State Kansas
 Sec. 14 (Blk. 23) (Sur. 12W) (Rge.) Map No.
 Operator F. E. Lockhart
 Well No. 1 Farm Thole
 Elev. 1847 Location NE SE SW

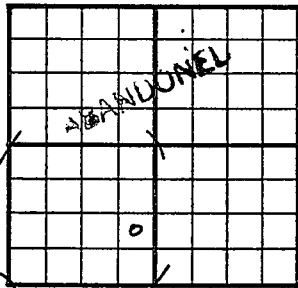

990 Ft. From S Line SW
330 Ft. From E Line Quarter
 Ist. Report
 Completion JUL 3 1951
 Remarks Wildcat
Veeder - Contr.
 Spudding Date 6-15-51

Drlg. Data D & A TD 3885
8" @ 278 Anhy 940 Lans. 3374
DST 3383-95 open 45 min. Rec. 30' mud
DST 3511-25 open 1 hr. Rec. 20' mud
Cong. 3694 Viola 3708 Simp. 3750
DST 3711-53 open $\frac{1}{2}$ hr. Rec. 30' mud
Arb. 3809-85 TD

D & A

J. E. TYRA