


StaffordnKANSAS

DX 78-1

Section 14 Township 23 Range 11W

Well No. 1 Proffitt

Company Sunray Oil

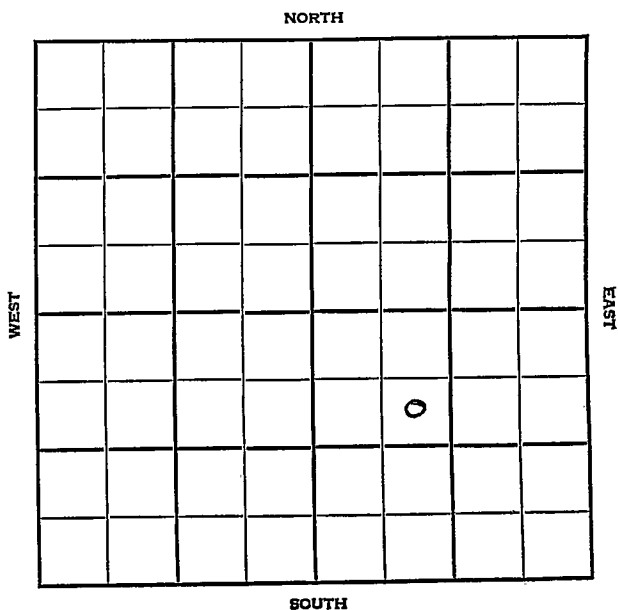

Stafford

KANSAS

SEC.	TWP.	R.
14	23	14 W

WELL NO.

1 Proffitt

FARM

COMPANY

Sunray Oil

CONTRACTOR

Stickle Drlg.

Glen Pool


990 Ft. from N. Line

Ft. from S. Line

Ft. from E. Line

990 Ft. from W. Line

SE NW SE

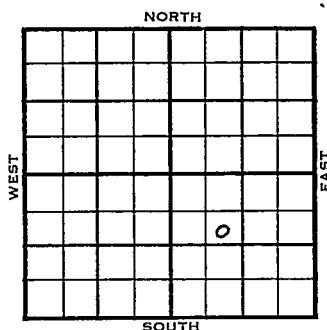

ELEVATION

REPORT

1954

1926'

6/23

Spud 6-21-54
8" @ 330

6/30

Drlg. 3370'

7/7

Spud 6-21-54 D & A TD 4040
 8" @ 330 Heeb 3386 Br. lime 3521
 Lans. 3534
 DST 3592-3618 open 1 hr rec 15' mud
 75#
 DST 3687-3711 open 1 hr rec 105' MCW
 1240# Cong. 3866 Viola 3879
 Simp. 3945 Arb. 3996
 TD 4040' D & A

ABANDONED

County **Stafford** State **Kansas**Sec. **14** (Blk.) **23** (Sur.) **14W** Map No.Operator **Sunray Oil**Well No. **1** Farm **Proffitt**Elev. Location **SE NW SE**

FIRST REPORT

0

990 Ft. From **N** Line **SE**990 Ft. From **W** Line Quarter1st. Report **JUN 23 1954**


Completion

Remarks

Stickle Drig. - Contr.Spudding Date **6-21-54**

Drig. Data

Glen Pool**8" @ 330**

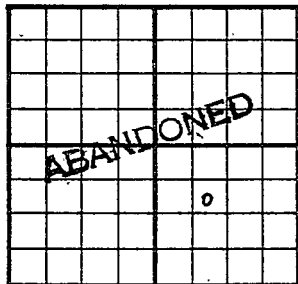County Stafford State KansasSec. 14 (Blk. Twp.) 23 (Sur. Rge.) 14W Map No. _____Operator Sunray OilWell No. 1 Farm ProffittElev. 1926 Location SE NW SE990 Ft. From N Line SE990 Ft. From W Line Quarter

1st. Report _____

Completion JUL 7 1954Remarks Glen PoolStickle Drlg. - Contr.Spudding Date 6-21-54Drlg. Data D & A TD 40408" @ 330 Heeb. 3386 Br. lime 3521Lans. 3534 DST 3592-3618 open 1 hr.Rec. 15' mud 75# DST 3687-3711open 1 hr. Rec. 105' mcw 1240#Cong. 3866 Viola 3879 Simp. 3945Arb. 3996 TD 4040D & A

J. G. McGEHEE