


Section 14 Township 23 Range 11W

Well No. 1 Taylor

Company Westgate-Greenland

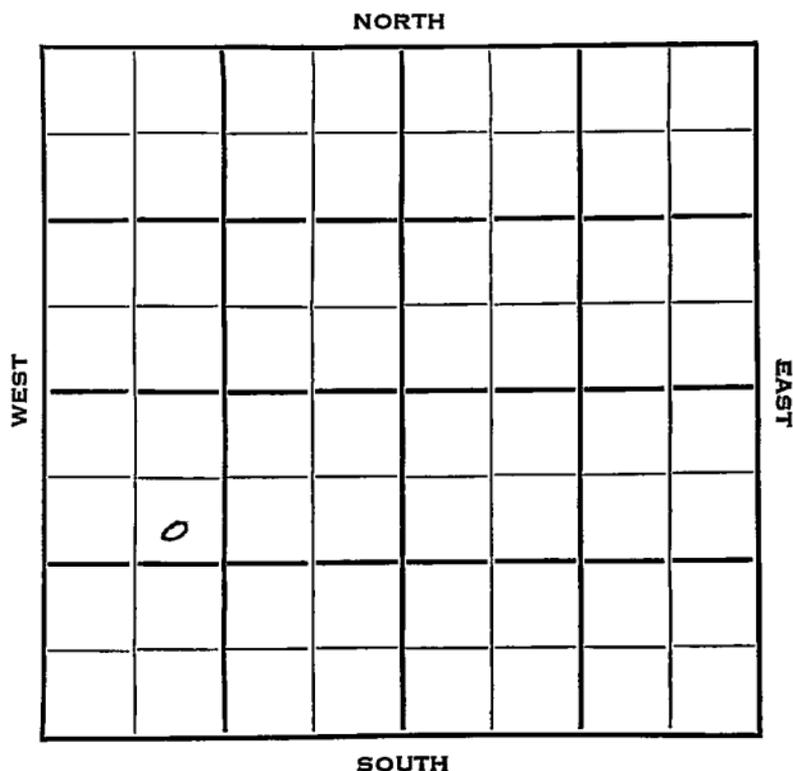

Stafford

KANSAS

Sec. 14 Twp. 23 R. 11W

Well No. 1 Taylor Farm

Westgate-Greenland Company

Wildcat Contractor


990 Ft. from N. Line

\_\_\_\_\_ Ft. from S. Line

\_\_\_\_\_ Ft. from E. Line

990 Ft. from W. Line

SE NW SW

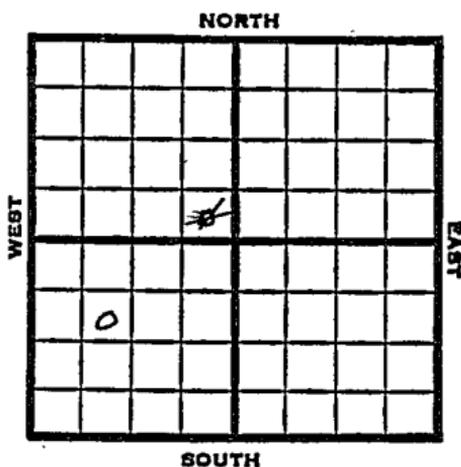

1953 Elev. 1931' REPORT

1/7 Location


1/22 Drlg. 3700'

1/28 Spud 1-10-53 D & A TD 4023'  
 8" @ 206 Anhy 833' Heeb 3392'  
 Br. lime 3525' Lans. 3539'  
 DST 3654-71 open 1 hr. rec 62' mud O#  
 DST 3697-3741 open 1 hr. rec 65' mud  
 1290# B KC 3784' Cong. 3871'  
 Viola 3884' Simp. 3954' Arb. 3999'  
 DST 4001-20 open 1 hr. rec 1700' sul.  
 wtr. 1250# TD 4023'  
 D & A

**ABANDONED**



County Stafford State Kansas  
 Sec. 14 (Blk. 23) (Sur. 14W) (Twp. 23) (Rge. 14W) Map No. \_\_\_\_\_  
 Operator Westgate-Greenland  
 Well No. 1 Farm Taylor  
 Elev. 1931 Location SE NW SW

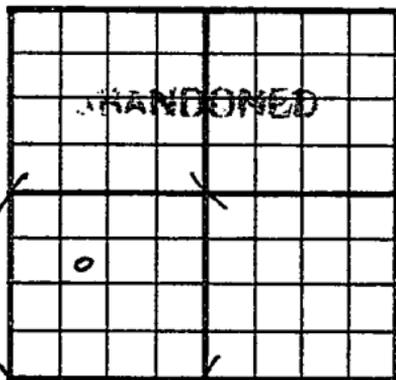

990 Ft. From N Line SW  
990 Ft. From W Line Quarter  
 Ist. Report \_\_\_\_\_  
 Completion JAN 28 1953  
 Remarks Wildcat

Spudding Date 1-10-53  
 Drlg. Data D & A TD 4023

8" @ 206 Anhy 833 Heeb. 3392  
Br. lime 3525 Lans. 3539 DST 3654-71  
open 1 hr. Rec. 62' mud 0# DST 3697-  
3741 open 1 hr. Rec. 65' mud 1290#  
B KC 3784 Cong. 3871 Viola 3884  
Simp. 3954 Arb. 3999 DST 4001-20  
open 1 hr. Rec. 1700' sul. wtr. 1250#  
TD 4023

D & A

J. G. MCGEHEE