

Section 14 Township 24 23 Range 14 WWell No. # 1 CrissmanCompany Natural Gas & Oil & Okla. Explor.

NORTH

WEST

EAST

SOUTH

0

Stafford

KANSAS

SEC.	14	TWP.	23 24	R.	14W ✓
WELL NO.					
#1 Crissman					
FARM					
COMPANY					
Natural Gas & Oil & Oklahoma Explor.					
CONTRACTOR					
Co. Tools.					


_____ Ft. from N. Line

990 _____ Ft. from S. Line

_____ Ft. from E. Line

330 _____ Ft. from W. Line

NW SW SE

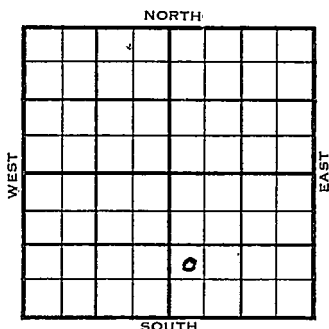

	ELEVATION	REPORT
1953	1924'	
11/24	M I R	
12/9	8" @ 201' w/200 Heeb 3382', Br li 3515', Lans 3527' DST 3644-58', 1 hr., 2160' gas, 45' SO& GCM, 60' frothy oil, 1180# DST 3677-3725', 1 hr., 35' M, 1125# B KC 3773', Cong 3851', V 3865' Drlg. 3910'	
12/16	Simp 3941', Arb 3994', RTD 4044' 5" @ 3770' WOCT	
1954 1/20	Spud 11-25-53 Oil Well TD 4044' 8" @ 201' Heeb 3382', Br lime 3515', Lans 3527' DST 3644-58', opn 1 hr., 2160' gas, 45' so & gcm, 60' frothy oil, 1180# DST 3677-3725', opn 1 hr., rec. 35' mud, 1125# B KC 3773', Cong. 3851', Viola 3865', Simp. 3941', Arb. 3994' TD 4044' 5" @ 3770'	

OVER

(Information Brought Forward)

1954
1/20

CO to 37373:

36/3651-57 6 go 6 gw $\frac{1}{4}$ hrs., 1200A

23 bo 1 hrs., 28 bo 2nd hr., 27 bo
3rd hr., 26 boph 8 hrs.

P/16 boph

Comp. 143 bopd 36% wtr.

COMPLETED

County Stafford State Kansas

Sec. 14 (Blk. 24) (Sur. 14W) Map No. _____

Operator **Natural Gas & Oil & Oklahoma Explor.**

Well No. 1 Farm Crissman

Elev.	Location	NW	SW	SE
-------	----------	----	----	----

REPORT

990 Ft. From S Line SE

330 Ft. From W Line Quarter

1st. Report NOV 24 1952

Completion

Remarks

Com. tools

Spudding Date

Drlg. Data

L I R

Kansas

Map No. _____ Sec. 14 Twp. 23 R. 14WWell No. 1 CrissmanNatural Gas & Oil & Okla. Explor.
Company

CORRECTION

Contractor


NW SW SE

SECTION PLAT

_____ Ft. from N. Line

990 Ft. from S. Line

_____ Ft. from E. Line

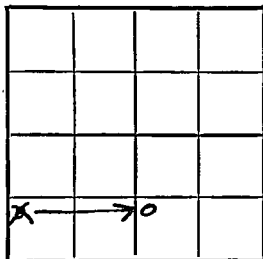330 Ft. from W. Line

Stafford County

Location _____

Rig up _____

Drilling and Remarks:

Reported

14-24-14W

RECORD

Cased _____ in., _____ ft.

Sand _____

Gas _____

Oil _____

Total Depth _____

PRODUCTION

1st 24 hrs. Nat. _____

1st 24 hrs. after shot _____

Gas _____ Cu. Ft.

Dry Hole _____

Abandoned _____

Date

DEC 2 1952
19

J. G. McGEHEE

Scout

J. G. McGEHEE