

Sec. 14 Twp. 23 R. 22 W ✓

Well No. # 1 Osborne Farm

Flynn Oil Co. Company

Barbour Drlg. Contractor

Wildcat


_____ Ft. from N. Line

330 Ft. from S. Line

330 Ft. from E. Line

_____ Ft. from W. Line

SE SE SW

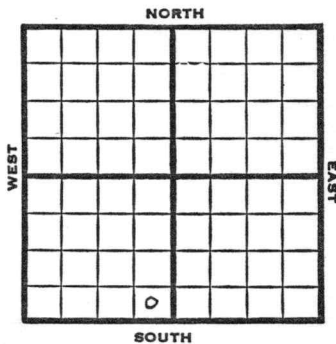

1951

Elev. 2200'

REPORT

6/6

Spud 5-30-51
8" @ 230 Anhy 1325-54'
Drlg. 2631'

6/20

Spud 5-39-51 D & A TD 4560'
8" @ 230 Anhy 1325-54' KC 3879'
B KC 4231' Mar. 4420' Miss 4486'
TD 4560' D & A

ABANDONED


County Hodgeman State Kansas

Sec. 14 (Blk. 23) (Sur. 22W) (Twp.) 23 (Rge.) 22W Map No.

Operator Flynn Oil Co.

Well No. 1 Farm Osborne

Elev. 2200 Location SE SE SW

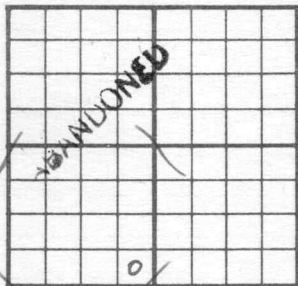

330 Ft. From S Line SW

330 Ft. From E Line Quarter

1st. Report

Completion JUN 20 1951

Remarks Wildcat

Barbour Drlg. - Contr.

Spudding Date 5-30-51

Drlg. Data D & A TD 4560

8" @ 230 Anhy 1325-54 KC 3879

B KC 4231 Mar. 4420 Miss. 4486

TD 4560 D & A