


Finney

Section 14 Township 23 Range 33W

Well No. #1 Bebermeyer

Company Northern Pump

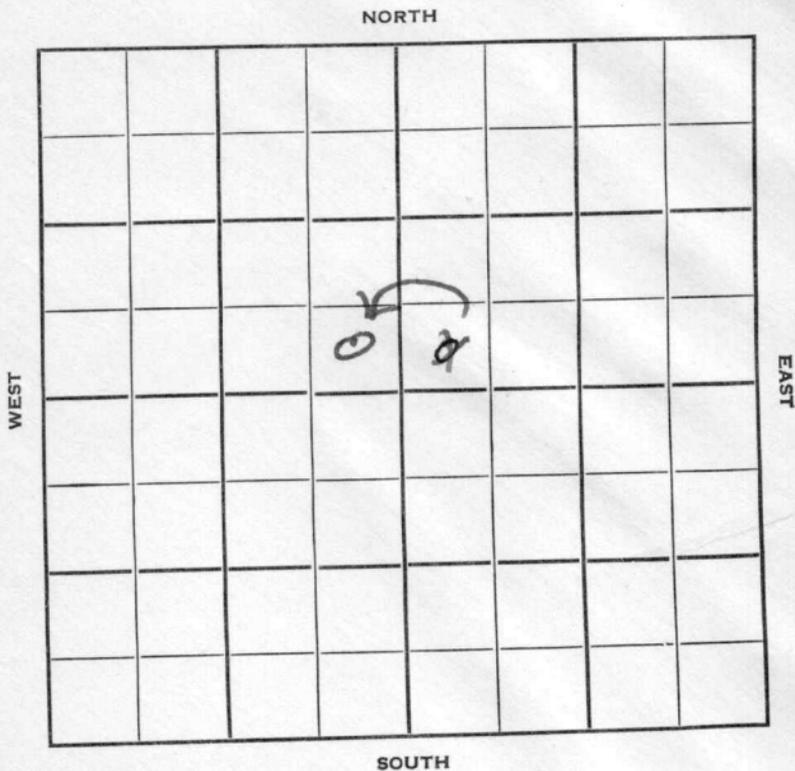

Finney KANSAS 33W  
23

14

Sec. \_\_\_\_\_ Twp. \_\_\_\_\_ R. \_\_\_\_\_

Well No. #1 Bebermeyer Farm

Northern Pump Company

Contractor


\_\_\_\_\_ Ft. from N. Line

150 Ft. from S. Line

150 Ft. from E. Line

150 Ft. from W. Line

~~SE NW~~  
~~SW NE~~

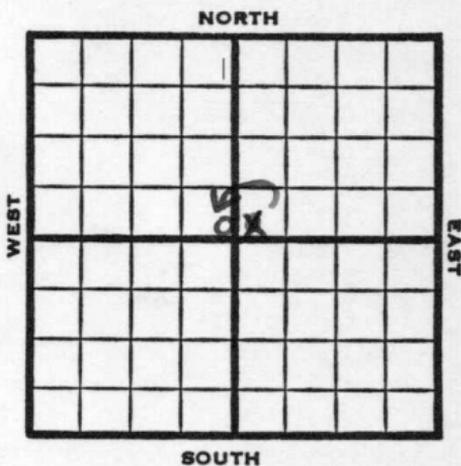

1953

Elev. 2887'

REPORT

3/18

Location

3/26

10" @ 356 RTD 2627 6" @ 2620  
Schl tops: Hog 2532' Her 2559'  
Kri 2584 Win 2617'

4/2

NR

4/9

Testing

4/16

"

4/22

Spud 3-16-53

Gas Well

TD 2627

10" @ 356

Her 2559, Kri 2584, Win 2617

TD 2627

6" @ 2620

CO to 2627

120/2582-2602, 96/2560-76, 6000 A-frac

Comp. 5,579,000 gas, 404#

COMPLETED



Map No. \_\_\_\_\_ Sec. 14 Twp. 23 R. 33W

Well No. 1 Bebermeyer


Northern Pump Company

**CORRECTION**

Contractor

SE NW

**SECTION PLAT**

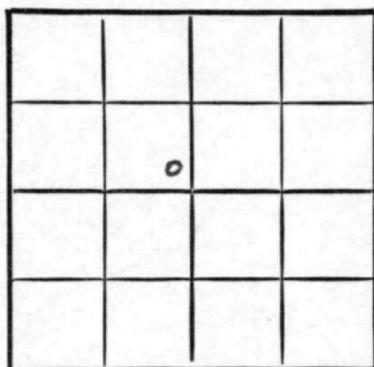

\_\_\_\_\_ Ft. from N. Line

150 Ft. from S. Line

150 Ft. from E. Line

\_\_\_\_\_ Ft. from W. Line

Finney County

Location \_\_\_\_\_

Rig up \_\_\_\_\_

Drilling and Remarks:

Reported  
SW NE

**RECORD**

Cased \_\_\_\_\_ in., \_\_\_\_\_ ft.

Sand \_\_\_\_\_

Gas \_\_\_\_\_

Oil \_\_\_\_\_

Total Depth \_\_\_\_\_

**PRODUCTION**

1st 24 hrs. Nat. \_\_\_\_\_

1st 24 hrs. after shot \_\_\_\_\_

Gas \_\_\_\_\_ Cu. Ft.

Dry Hole \_\_\_\_\_

Abandoned \_\_\_\_\_

Date

MAR 25 1951

J. G. McGEHEE

Scout

