


Section 14 Township 23 Range 36 W

Well No. # 1 Keeman "C"

Company Stanö Lind

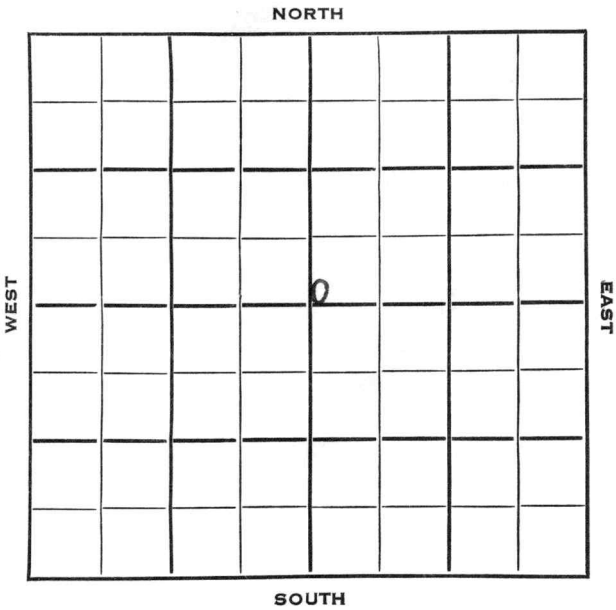

Kearny

KANSAS ✓

Sec. 14 Twp. 23 R. 36WWell No. #1 Kleeman "C" FarmStanolind

Company

Contractor

Hugoton Pool

Ft. from N. Line

150


Ft. from S. Line

Ft. from E. Line

150

Ft. from W. Line

SW SW NE

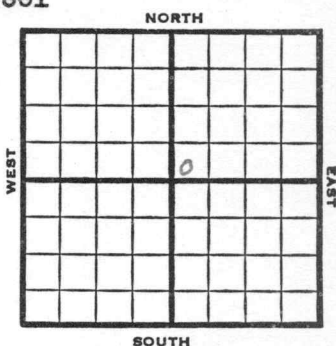

1953

Elev. 3126'

REPORT

8/5

Location

8/12

8" @ 750'

Her. Kr. 2594', Win 2609', Tow 2676'

RTD 2704'

elec log.

5" @ 2676'

8/19

N.R.

8/26

CO, Testing

9/2

Spud 8-3-53

Gas Well

TD 2704'

8" @ 750'

Her. 2549, Win 2609, Tow 2676

TD 2704'

5" @ 2676'

CO to 2688 dol-frac 42/ 2549-56

48/ 2558-66 18/ 2569-71 42/ 2581-

88 24/ 2592-96 24/ 2606-10


84/ 2614-28 24/ 2638-42 24/ 2646-

50 24/ 2660-64 dol-frac

Comp. 8,669,000 gas 395#

COMPLETED

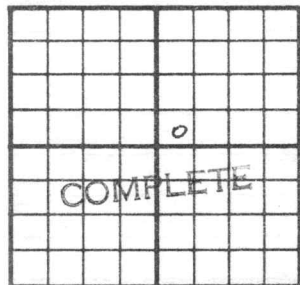

County Kearny State KansasSec. 14 (Blk.) 23 (Sur.) 36W Map No.Operator StanolindWell No. 1 Farm Kleeman "C"Elev. 3126 Location SW SW NE150 Ft. From S Line NE150 Ft. From W Line Quarter1st. Report SEP 2 1953Completion SEP 2 1953Remarks Hugoton PoolSpudding Date 8-3-53Drlg. Data Gas well TD 27048" @ 750 Her. 2549 Win. 2609Tow. 2676 TD 2704 5" @ 2676CO to 2688 dol-frac 42/ 2549-5648/ 2558-66 18/ 2569-71 42/ 2581-8824/ 2592-96 24/ 2606-10 84/ 2614-2824/ 2638-42 24/ 2646-50 24/ 2660-64dol-frac Comp. 8,669,000 gas 395#

J. G. McGEHEE