


Map No. KANSAS Sec. 15 Twp. 23 R. 2<sup>w</sup>

Well No. 1-Meuller Farm  
Winkler-Koch et al Company

*Harvey*

NORTH

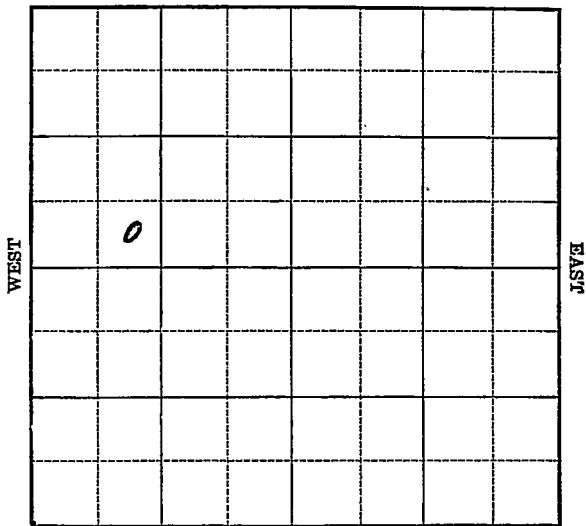

Location \_\_\_\_\_

Drilling Remarks \_\_\_\_\_

\_\_\_\_\_

\_\_\_\_\_

**RECORD**

Cased \_\_\_\_\_ in. \_\_\_\_\_ ft.

Sand \_\_\_\_\_

Gas \_\_\_\_\_

Oil \_\_\_\_\_

Total Depth \_\_\_\_\_

Rig Up \_\_\_\_\_

Drilling Remarks \_\_\_\_\_

\_\_\_\_\_

\_\_\_\_\_

**PRODUCTION**

1st 24 hrs. Nat. \_\_\_\_\_

1st 24 hrs. after shot \_\_\_\_\_

Gas \_\_\_\_\_ cu. ft.

Dry Hole \_\_\_\_\_

Abandoned \_\_\_\_\_

Harvey  
2W

Map No. KANSAS Sec. 15 Twp. 23 R. 2


Well No. 1- Mueller Farm  
Winkler-Koch et al Company

\_\_\_\_\_ Ft. from N. Line

330 Ft. from S. Line

\_\_\_\_\_ Ft. from E. Line

990 Ft. from W. Line

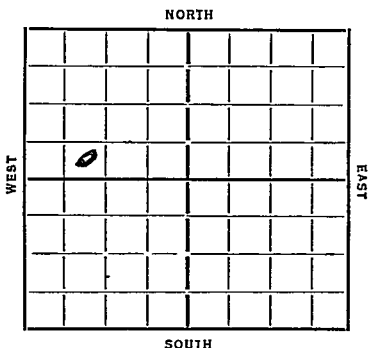

Date	REPORT
1935	
4/17	Bkly Rig
4/26	Spdy
5/2	— 59 —
5/16	8" 65 20" 145
5/23	" 650 15" 444
5/29	" 1045 12" 975
6/6	" 1800
6/13	" 2155 10" 2049
6/20	8" 2256 W R 8" 2455
6/28	2710 W R 8"
7/3	8" 3045 8" 2632
7/14	" 3210
7/18	seg 3210
8/7	Top-huntton 3670
	T. D. 3700
	N. & a. 3700
	ABANDONED

Map No. 39 Sec. 15 Twp. 23 R. 2W

Well No. 1-Meuller

Winkler-Koch et al Company

Contractor

**FIRST REPORTS**

**SECTION PLAT**

.....Ft. from N. Line

330 Ft. from S. Line

.....Ft. from E. Line

990 Ft. from W. Line

0			

Location.....

Rig up.....

Drilling and Remarks:

*Best Rig*

**RECORD**

Cased.....in., .....ft.

Sand.....

Gas.....

Oil.....

Total Depth.....

**PRODUCTION**

1st 24 hrs. Nat.....

1st 24 hrs. after shot.....

Gas.....Cu. Ft.

Dry Hole.....

Abandoned.....

Date

4-17-35

192

**ORVAL MANSCHRECK**

Scout

Map No. 39 Sec. 15 Twp. 23 R. 24

Well No. 1-Meuller

Winkler-Koch et al Company

Contractor

**ABANDONED SECTION PLAT**

.....Ft. from N. Line

330 Ft. from S. Line

.....Ft. from E. Line

990 Ft. from W. Line

0			

Location.....

Rig up.....

Drilling and Remarks:

10 + A

**RECORD**

Cased..... in, ..... ft.

Sand Hunton 3670

Gas.....

Oil.....

Total Depth 3700

**PRODUCTION**

1st 24 hrs. Nat.....

1st 24 hrs. after shot.....

Gas..... Cu. Ft.

Dry Hole.....

Abandoned.....

Date

8-7-35 192.....

**ORVAL MANSCHRECK**

Scout