

Reno

Section 15 Township 23 Range 10-WWell No. #3 Heylum (Heylman)Company Cities Service Oil


Peace Creek Pool

NORTH

WEST

EAST

SOUTH

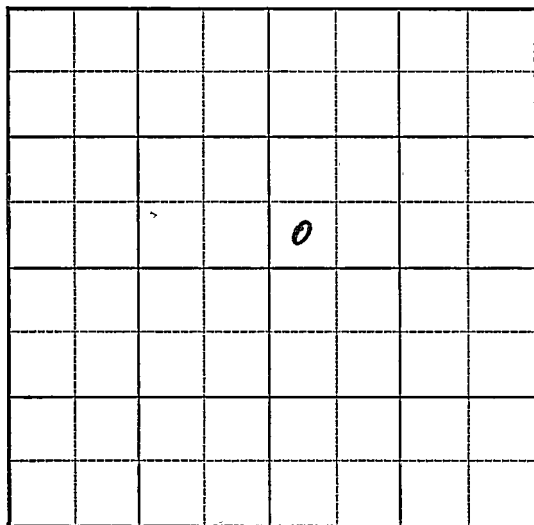

Map No. 47 Sec. 15 Twp. 23 R. 10WWell No. 3 Heylum

Cities Service Oil Company

FIRST REPORT Contractor

SW NE

SECTION PLAT

_____ Ft. from N. Line

330 Ft. from S. Line

_____ Ft. from E. Line

330 Ft. from W. Line

PEACE CREEK POOL

Location _____

Rig up _____

Drilling and Remarks:

Rotary

RECORD

Cased _____ in., _____ ft.

Sand _____

Gas _____

Oil _____

Total Depth _____

PRODUCTION

1st 24 hrs. Nat. _____

1st 24 hrs. after shot _____

Gas _____ Cu. Ft.

Dry Hole _____

Abandoned _____

Date

APR 22 1942 19

S. J. LEWIS Scout

Map No. 47 Sec. 15 Twp. 23 R. 10WWell No. 3 HeylumCities Service Oil CompanyCOMPLETED Contractor

SW NE

SECTION PLAT

		0	

 Ft. from N. Line330 Ft. from S. Line Ft. from E. Line330 Ft. from W. Line

PEACE CREEK POOL

Location Rig up

Drilling and Remarks:

*Vista 3789**5-103 790**Born & Pay 23364**May 3000**42 9/18*

RECORD

Cased in., ft.Sand Gas Oil Total Depth 3796

PRODUCTION

1st 24 hrs. Nat. 1st 24 hrs. after shot Gas Cu. Ft.Dry Hole Abandoned

Date

MAY 27 1942

19

S. J. LEWIS Scout