

KANSAS

Reno

FORM 51 5M 4-41 PETROL

Section 15 Township 23 Range 10-W

Well No. #1 Helymum (*Helymum*)

Company Cities Service Oil

Peace Creek Pool

NORTH

							0

WEST

EAST

SOUTH

KANSAS

Reno

Sec. 15 Twp. 23 R. 10-W

Well No. #1 Helymum Farm

Cities Service Oil Company

(Peace Creek)


330 Ft. from N. Line

 Ft. from S. Line

330 Ft. from E. Line

 Ft. from W. Line

Elw. 1770

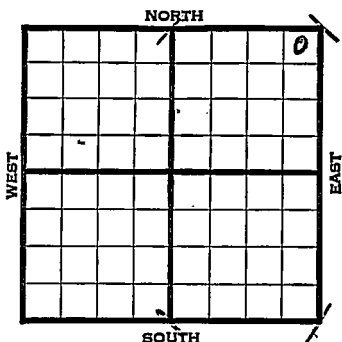

1941	REPORT
12/17	Rotary
12/24	8" - 198' Drlg. 2400'
12/31	Drl g. 3447'
1942	
1/8	Viola ³⁷⁵⁸ 3764-68 ' T.D.
	5" - ³⁷⁶⁰ 3766 ' RUST.
1/15	Viola 3758' (Corrected)
	5" - 3760' T.D. 3768'
	1500 acid. Flow 12 oil per hr.
1/22	T.D. 3776' 2500 acid.
	Flow 13 oil per hour 12 hours,
	3/4" choke.

OVER

1942
1/28

Viola 3758'

5" - 3760'

T.D. 3776'

4000 acid.

Bomb potential 1348 oil & 421 water.

42. Gravity

COMPLETED

Reno

KANSAS

Map No. 47 Sec. 15 Twp. 23 R. 10WWell No. 1 HelymumCities Service Oil Company

Contractor

FIRST REPORT

NE/C


330 Ft. from N. Line

Ft. from S. Line

330 Ft. from E. Line

Ft. from W. Line

SECTION PLAT

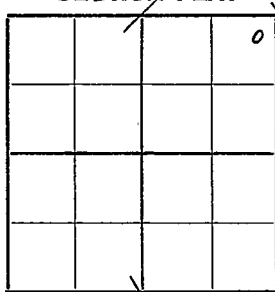

PEACE CREEK POOL

Location _____

Rig up _____

Drilling and Remarks:

RECORD

Cased _____ in., _____ ft.

Sand _____

Gas _____

Oil _____

Total Depth _____

Rotary

PRODUCTION

1st 24 hrs. Nat. _____

1st 24 hrs. after shot _____

Gas _____ Cu. Ft.

Dry Hole _____

Abandoned _____

Date

DEC 17 1941

19

S. J. LEWIS Scout

Reno

KANSAS

Map No. 47 Sec. 15 Twp. 23 R. 10WWell No. 1 HeylmumCities Service Oil Company**COMPLETED**

Contractor

NE/C

SECTION PLAT

330 Ft. from N. Line Ft. from S. Line330 Ft. from E. Line Ft. from W. Line

			a

PEACE CREEK POOL

Location Rig up Drilling and Remarks: Vista 3758.5" C 37604000 cu ftBon + P 8 1348oil + 421 water420 Gr

RECORD

Cased in., ft.Sand Gas Oil Total Depth 3726

PRODUCTION

1st 24 hrs. Nat. 1st 24 hrs. after shot Gas Cu. Ft.Dry Hole Abandoned

Date

JAN 28 1942

19

S. J. LEWIS

Scout