

KANSAS

Reno

FORM 51 5M 4-41 PETROL


Section 15 Township 23 Range 10-W

Well No. #5 Heylum (Heylman)

Company Cities Service Oil


NORTH Peace Creek Pool

2.

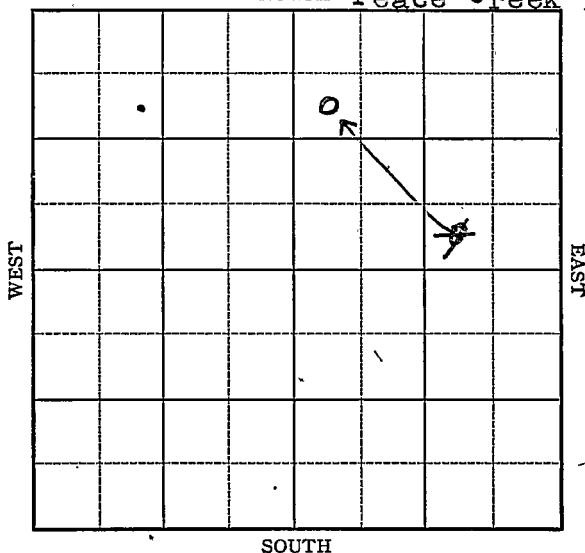

Sec. 15 Twp. 23 R. 10-WWell No. #5 Heylum FarmCities Service Oil Company

(Peace Creek)

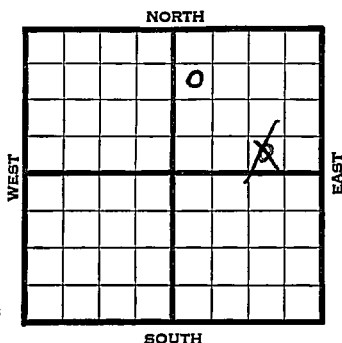990 Ft. from N. Line330 Ft. from S. Line990 Ft. from E. Line330 Ft. from W. LineElev. 1777
~~1731~~

1942	REPORT
5/20	Cellar.
5/27	8" - 276' WOC.
6/3	Drlg. 2650'
6/10	Viola 3775-78' T.D. Run casing.
6/17	5" - 3777' Drlg. 3798' No shows.
6/24	T.D. 3801' 3000 acid. Swab 49 oil in 8 hours.
7/1	Pump 1 oil & 10 water 8 hours. Will acidize.
7/8	Viola 3775' 5" - 3777' T.D. 3801' 7000 acid. Pump 64 oil & 20 water. 42. Gravity
	COMPLETED

Reno

KANSAS

Map No. 47 Sec. 15 Twp. 23 R. 10WWell No. 5 HeylumCities Service Oil Company**FIRST REPORT**

Contractor

SW SE NE

SECTION PLAT

			o

 Ft. from N. Line330 Ft. from S. Line990 Ft. from E. Line Ft. from W. Line**PEACE CREEK POOL**Location Rig up

Drilling and Remarks:

Cellar

RECORDCased in., ft.Sand Gas Oil Total Depth **PRODUCTION**1st 24 hrs. Nat. 1st 24 hrs. after shot Gas Cu. Ft.Dry Hole Abandoned

Date

MAY 20 1942

19

S. J. LEWIS Scout

Reno

KANSAS

Map No. 47 Sec. 15 Twp. 23 R. 10WWell No. 5 Heylum

Cities Service Oil

Company

CORRECTION

Contractor

SW NW NE

SECTION PLAT

990 Ft. from N. Line

_____ Ft. from S. Line

_____ Ft. from E. Line

330 Ft. from W. Line

		0	

PEACE CREEK POOL

Location _____

Rig up _____

Drilling and Remarks:

Reported as

SW SE NE

RECORD

Cased _____ in., _____ ft.

Sand _____

Gas _____

Oil _____

Total Depth _____

PRODUCTION

1st 24 hrs. Nat. _____

1st 24 hrs. after shot _____

Gas _____ Cu. Ft.

Dry Hole _____

Abandoned _____

Date

JUN 3 1942

19

S. J. LEWIS

Scout

Reno

KANSAS

Map No. 47 Sec. 15 Twp. 23 R. 10WWell No. 5 HeylumCities Service Oil Company**COMPLETED**

Contractor

SW NW NE

SECTION PLAT

		o	

990 Ft. from N. Line Ft. from S. Line Ft. from E. Line330 Ft. from W. LinePEACE CREEK POOL.Location Rig up

Drilling and Remarks:

*Vista 3775**5" @ 3777**7000 cu ft**Pump 64 oil +
20 water**42 2/3*

RECORD

Cased in., ft.Sand Gas Oil Total Depth 3801

PRODUCTION

1st 24 hrs. Nat. 1st 24 hrs. after shot Gas Cu. Ft.Dry Hole Abandoned

Date

JUL 8 1942 19 S. J. LEWIS Scout