


KANSAS

Reno.

Section 15 Township 23 Range 10W

Well No. 4 Werner

Company Republic Natural Gas

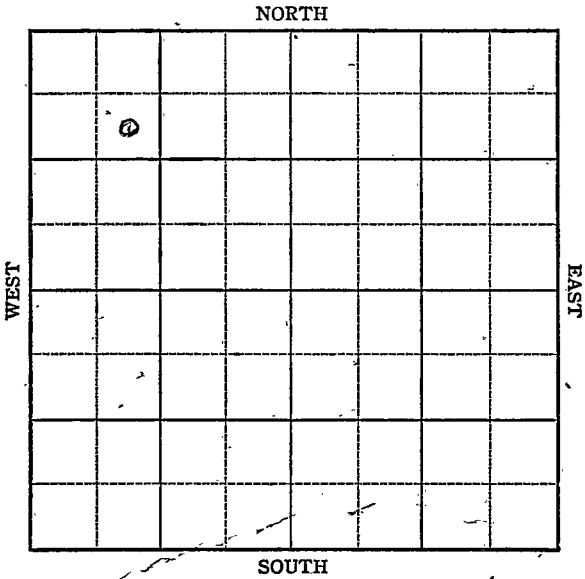

KANSAS

Reno

Sec. 15 Twp. 23 R. 10-WWell No. 4 Werner FarmRepublic Natural Gas Company


990 Ft. from N. Line

Ft. from S. Line

Ft. from E. Line

990 Ft. from W. Line

SE NW NW

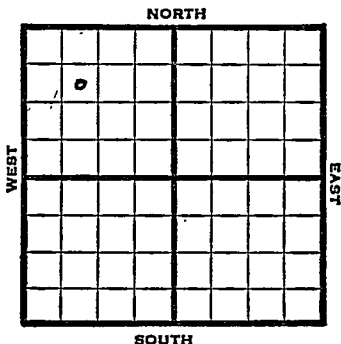

1947	Elev. 1770'	REPORT
6/4	Location	
6/10	RUR	
6/17	10" @ 208'	
	Drlg. 1860'	
6/24	Drlg. 3535'	
7/1	Drlg 3660'	
7/8	Viola 3649'	
	7" @ 3655'	
	TD 3660'	
	RUST	
7/16	TD 3675'	
	500 acid	
	Swab 3 bbls. oil PH - 24 hrs.	
7/22	"	
7/29	TD 3675'	
8/6	Viola 3649'	
	7" @ 3655'	
	500 Acid.	
	Pump 46 Pot.	
	Gr. 40.7	
	T.D. 3675'	
	Complete	

COMPLETED

Map No. _____ Sec. 15 Twp. 23 R. 10W

Well No. 4 Werner

Republic Natural Gas Company

FIRST REPORT Contractor

SE NW NW

SECTION PLAT

990 Ft. from N. Line

_____ Ft. from S. Line

_____ Ft. from E. Line

990 Ft. from W. Line

o			

René County

Location X

Rig up _____

Drilling and Remarks:

RECORD

Cased _____ in., _____ ft.

Sand _____

Gas _____

Oil _____

Total Depth _____

PRODUCTION

1st 24 hrs. Nat. _____

1st 24 hrs. after shot _____

Gas _____ Cu. Ft.

Dry Hole _____

Abandoned _____

Date

JUN 4 1947

19

S. J. LEWIS

Scout

Kansas Peace Creek Pool

Map No. 47 Sec. 15 Twp. 23 R. 10WWell No. 4 WernerRepublic Natural Gas Company**COMPLETE**

Contractor

SE NW NW

E1.1770
SECTION PLAT990 Ft. from N. Line Ft. from S. Line Ft. from E. Line990 Ft. from W. Line

a			

Reno County

Location Rig up

Drilling and Remarks:

*Vid 3649**7" @ 3655**500 cu. ft.**Pump 46 B.Y.**NO 2 1/2***RECORD**Cased in., ft.Sand Gas Oil Total Depth 3675**PRODUCTION**1st 24 hrs. Nat. 1st 24 hrs. after shot Gas Cu. Ft.Dry Hole Abandoned

Date

AUG 6 1947 19S. J. LEWIS

Scout