

KANSAS

Reno

FORM 51 5M 10-41 PETROL

Section 15 Township 23 Range 10-W

Well No. #2 Werner

Company Republic Natural Gas

NORTH Peace Creek Pool

		0						

WEST EAST

SOUTH

3

Sec. 15 Twp. 23 R. 10-W

Well No. #2 Werner Farm

Republic Natural Gas Company


(Peace Creek)

990 Ft. from N. Line

 Ft. from S. Line

990 Ft. from E. Line

 Ft. from W. Line

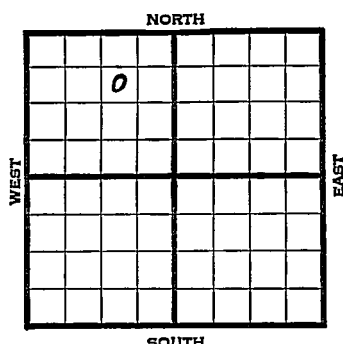

Elev. 1772

1942	REPORT
4/29	Derrick.
5/6	8" - 215' Drlg. 2875'
5/13	Viola 3749-55' T.D. 5" - 3754' RUST.
5/20	Drlg. 3765' No shows.
5/27	T.D. 3771' 3000 acid.
	Swab & flow 32 oil per hour 8 hours.
6/3	Pump 19 oil per hour, 8 hours.
6/10	Temp. potential 482 bbls., pump.
6/17	" " "
6/24	" " "
7/1	" " "
7/8	Viola 3749'
	5" - 3754'
	T.D. 3771'
	3000 acid.
	Bomb potential 1170 bbls.
	42. Gravity
	COMPLETED

KANSAS

Reno

Map No. 47 Sec. 15 Twp. 23 R. 10 WWell No. 2 Werner

Republic Natural Gas Company

FIRST REPORT

Contractor

SW NE NW

990 Ft. from N. Line Ft. from S. Line990 Ft. from E. Line Ft. from W. Line

SECTION PLAT

	o		

PEACE CREEK POOL

Location Rig up

Drilling and Remarks:

Derrick

RECORD

Cased in., ft.Sand Gas Oil Total Depth

PRODUCTION

1st 24 hrs. Nat. 1st 24 hrs. after shot Gas Cu. Ft.Dry Hole Abandoned

Date

APR 29 1942 19

S. I. LEWIS Scout

Map No. 47 Sec. 15 Twp. 23 R. 10WWell No. 2 WernerRepublic Natural Gas Company**COMPLETED**

Contractor

SW NE NW

SECTION PLAT

	6		

990 Ft. from N. Line Ft. from S. Line990 Ft. from E. Line Ft. from W. Line

PEACE CREEK POOL

Location Rig up

Drilling and Remarks:

*Vista 3749**5" 3754**3000 acid**Bom & P 8/1/70**420/82*

RECORD

Cased in., ft.Sand Gas Oil Total Depth 3771

PRODUCTION

1st 24 hrs. Nat. 1st 24 hrs. after shot Gas Cu. Ft.Dry Hole Abandoned

Date

JUL 8 1942 19S. J. LEWIS Scout