

Sec 15 Twp. 23 R. 10-W

Well No. #3 Yust Farm

Magnolia Company

(Peace Creek)


990 Ft. from N. Line

_____ Ft. from S. Line

990 Ft. from E. Line

_____ Ft. from W. Line

Elev. 1776

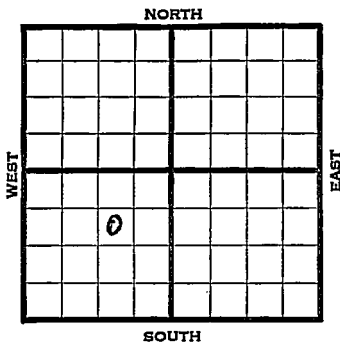

1941	REPORT
12/23	10" - 279' WOC.
12/31	Drlg. 2095'
1942	
1/8	Drlg. 3510'
1/15	Viola 3765' 5" - 3769'
	T.D. 3774' H.F.O.
1/21	Viola 3765'
	5" - 3769'
	T.D. 3774'
	1000 acid.
	Bomb potential 16,470 bbls.
	Maximum 3000 bbls.
	42. Gravity
	COMPLETED

Reno

Map No. 47 Sec. 15 Twp. 23 R. 10WWell No. 3 YustMagnolia

Company

FIRST REPORT

Contractor

SW NE SW

SECTION PLAT

990 Ft. from N. Line

_____ Ft. from S. Line

990 Ft. from E. Line

_____ Ft. from W. Line

PEACE CREEK POOL

Location _____

Rig up _____

Drilling and Remarks:

10" - 279'Waiting on
cement to set

RECORD

Cased _____ in., _____ ft.

Sand _____

Gas _____

Oil _____

Total Depth _____

PRODUCTION

1st 24 hrs. Nat. _____

1st 24 hrs. after shot _____

Gas _____ Cu. Ft.

Dry Hole _____

Abandoned _____

Date

DEC 23 194119S. J. LEWIS Scout

KANSAS

Reno

Map No. 47 Sec. 15 Twp. 23 R. 10WWell No. 3 YustMagnolia CompanyCOMPLETED Contractor

SW NE SW

SECTION PLAT

990 Ft. from N. Line

_____ Ft. from S. Line

990 Ft. from E. Line

_____ Ft. from W. Line

PEACE CREEK POOL

Location _____

Rig up _____

Drilling and Remarks:

*Viola 3765**5" C 3769**1000 acid**Born & Pat 16470**May 3000**42 1/2 hr*

RECORD

Cased _____ in., _____ ft.

Sand _____

Gas _____

Oil _____

Total Depth 3774

PRODUCTION

1st 24 hrs. Nat. _____

1st 24 hrs. after shot _____

Gas _____ Cu. Ft.

Dry Hole _____

Abandoned _____

Date

JAN 21 1942 19

S. J. LEWIS Scout