


Stafford

KANSAS

Section 15 Township 23 Range 13WWell No. #1 WardCompany Imperial Pet.

NORTH

WEST

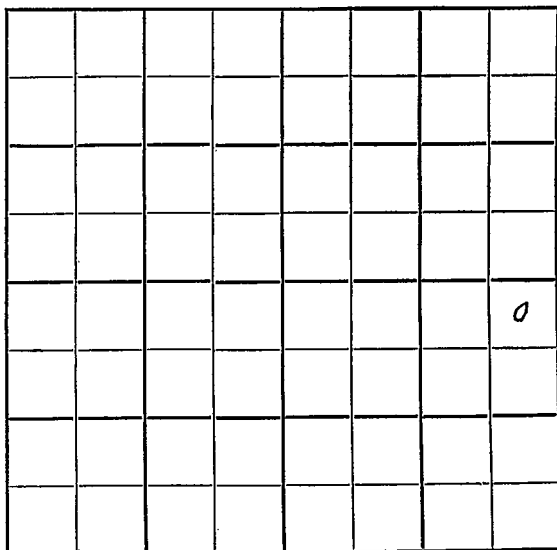

EAST

SOUTH

Sec. 15 Twp. 23 R. 13 W

Well No. # 1 Ward Farm

Imperial Pet. Company

Contractor

Wildcat

330 Ft. from N. Line

 Ft. from S. Line


330 Ft. from E. Line

 Ft. from W. Line

NE NE SE

MCPC has ~~87~~ of 14
SE


MCPC has 160 A. SOUTH $\frac{1}{2}$ Mi EAST

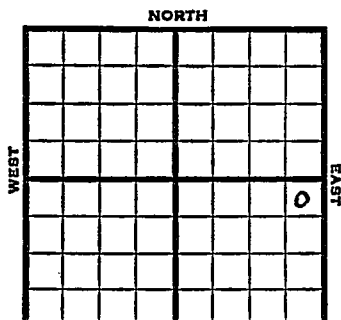

1951 Elev. 1882' REPORT

3/7 Location

3/28 Spud 3-7-51
D&A TD 3921
8" @ 306'
Heeb. 3284' Br Lime 3420
Lans. 3443'
DST 3461-85 opn $\frac{1}{2}$ hr
Rec. 11' mud DST 3569-81 opn 1 hr
Rec. 12' sgcm
DST 3600-20 opn $\frac{1}{2}$ hr
Rec. 12' socm Viola 3767'
DST 3769-77 opn 45 min Rec. 6' socm
Simp 3832' Arb. 3888'
TD 3921'
D&A
ABANDONED

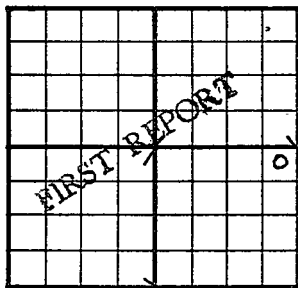County Stafford State KansasSec. 15 (Blk. Twp.) 23 (Sur. Rge.) 13W Map No.Operator Imperial Pet.Well No. 1 Farm WardElev. Location NE NE SE330 Ft. From N Line SE330 Ft. From E Line Quarter1st. Report MAR 7 1951

Completion


Remarks

MCPC has SW of 14

Spudding Date

Drilg. Data WildcatLocation

J. E. TYRA

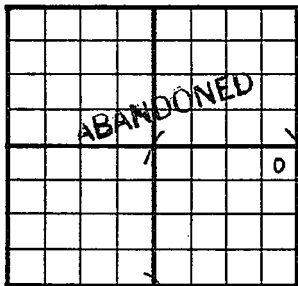County Stafford State KansasSec. 15 (Blk.
Twp.) 23 (Sur.
Rge.) 1 3W Map No.Operator Imperial Pet.Well No. 1 Farm WardElev. 1882 Location NE NE SE330 Ft. From N Line SE330 Ft. From W Line Quarter

1st. Report

Completion MAR 28 1951Remarks WildcatSpudding Date 3-7-51Drilg. Data D & A TD 39218" @ 306 Heeb. 3284 Br. lime 3420Lans. 3443 DST 3461-85 open $\frac{1}{2}$ hr.Rec. 11' mud DST 3569-81 open 1 hr.Rec. 12' sgcm DST 3600-20 open $\frac{1}{2}$ hr.Rec. 12' socm Viola 3767 DST 3769-77open 45 min. Rec. 6' socm Simp. 3832Arb. 3888 TD 3921D & A

J. E. TYRA