


Section 15 Township 23 Range 13 WWell No. # 1 WardCompany Petroleum Inc.

NORTH

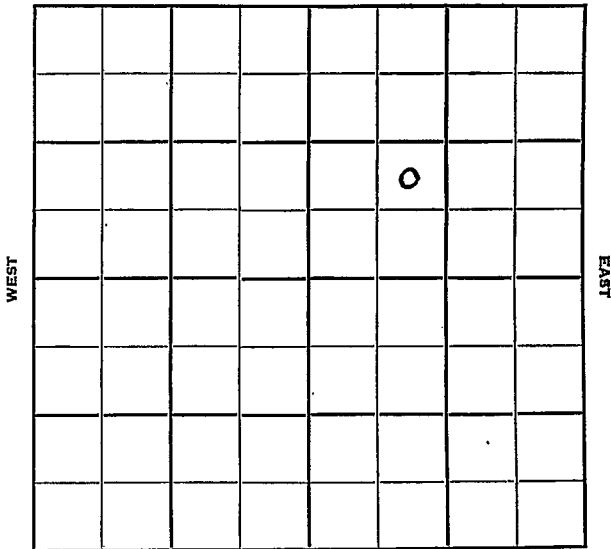

SOUTH

Stafford

KANSAS

Sec. 15 Twp. 23 R. 13W

Well No. #1 Ward Farm

Petroleum, Inc. Company

Garvey - Contr. Contractor

Wildcat


Ft. from N. Line

990' Ft. from S. Line

Ft. from E. Line

990' Ft. from W. Line

NE SW NE

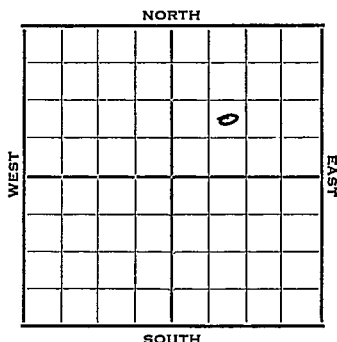

1952 Elev. 1880' REPORT

4/9	Spud 4-6-52 8" @ 255 WOC
-----	--------------------------------

4/16 Anhy 760 Heeb. 3276 Dodge 3297
Douglas 3311 Br Li 3411 Lans. 3428
DST 3512-25 1 hr. 30' OCM Q#
V. 3724 Simp. 3760 Arb. 3808
DST 3811-19 1 hr. 270' free oil
120' muddy oil 1255# RTD 3819
5" @ 3810'

L/23	NR
------	----

4/30	NR
------	----

5/7 DP 3819 B/5 BOPH for 24 hrs.
tub & rods

5/14	NR
------	----

5/21	18
------	----

5/28 11

6/4 Spud 4-6-52
Oil Well TD 3819' 8" @ 255'
Anhy 760 Heeb. 3275
Dodge 3297 Doug. 3311
Br Li 3411 Lans. 3428
DST 3512-25 open 1 hr. rec. 30' ocm
Viola 3724 Simp. 3760
Arb. 3808 DST 3811-19 open 1 hr.
rec. 270' frée oil 120' muddy oil
TD 3819 5" @ 3810 DP to 3819
B/ 5 boph Comp. 36 bopd 35% wtr.

COMPLETED

County **Stafford** State **Kansas**
 Sec. **15** (Blk. Twp.) **23** (Sur. Rge.) **15W** Map No.

Operator **Petroleum Inc.**

Well No. **1** Farm **Ward**

Elev. Location **NE SW NE**

990 Ft. From **S** Line **NE**

990 Ft. From **W** Line Quarter

1st. Report **APR 9 1952**

Completion

Remarks **Stanolind-support**
Garvey- Contr.

Spudding Date **4-6-52**


Wildcat

Drlg. Data

8" @ 255 WOC

J. G. McGEHEE

County Stafford State Kansas
 Sec. 15 (Blk. 23 (Sur. 13W Map No.
 (Twp.) (Rge.)
 Operator Petroleum Inc.
 Well No. 1 Farm Ward
 Elev. 1880 Location NE SW NE

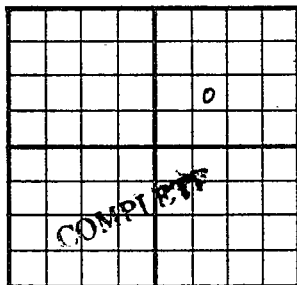

990 Ft. From S Line NE
990 Ft. From W Line Quarter
 1st. Report
 Completion JUN 4 1952
 Remarks Wildcat
Garvey - Contr.
 Spudding Date 4-6-52

Drlg. Data Oil well TD 3819
8" @ 255 Anhy 760 Heeb. 3276
Dodge 3297 Doug. 3311 Br. lime 3411
Lans. 3428 DST 3512-25 open 1 hr.
Rec. 30' ocm Viola 3724 Simp. 3760
Arb. 3808 DST 3811-19 open 1 hr.
Rec. 270' free oil 120' muddy oil
TD 3819 5" @ 3810 DP to 3819
B/ 5 boph Comp. 36 bopd 35% water

J. G. McGEHEE