

KANSAS Stafford

Section 15 Township 23 Range 14WWell No. 1 CoenCompany Huber & Harbar

Wildcat

NORTH

WEST								
								0

EAST

SOUTH

Sec. 15 Twp. 23 R. 14W

Well No. 1 Coen Farm

Huber & Harbar Company
Wildcat


 Ft. from N. Line

330 Ft. from S. Line

330 Ft. from E. Line

 Ft. from W. Line

SE/C

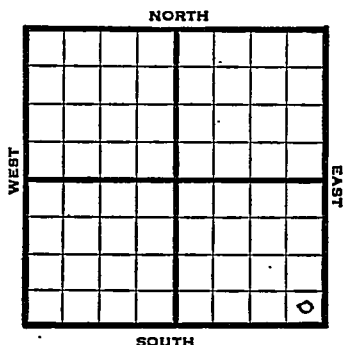

1948 Elev. 1934' REPORT

8/25 Location

9/1 "

9/8 "

9/14 "

9/21 8" @ 377'
Drlg. 828'


9/29 Drlg. 2282'

10/6 Lansing 3549'
Drlg. 3665'

10/13 Viola 3877'
Simp. 3975'
Arb. 4013
TD 4045'
ABANDONED

Stafford County Kansas StateMap No. _____ Sec. 15 Twp. 23 R. 14WWell No. 1 CoenHuber & Harbar CompanyFIRST REPORT ContractorSE/C

SECTION PLAT

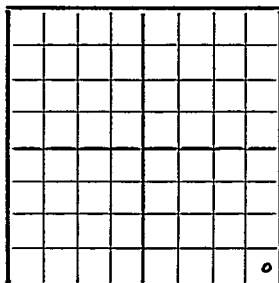 Ft. from N. Line330 Ft. from S. Line330 Ft. from E. Line Ft. from W. LineWildcat

Remarks:

Location

Date AUG 25 1948Scout S. J. LEWIS

Map No. 83 Sec. 15 Twp. 23 R. 14W

Well No. 1 Coen

Huber & Harbar Company

ABANDONED

Contractor

SE/C


E1184
SECTION PLAT

 Ft. from N. Line

330 Ft. from S. Line

330 Ft. from E. Line

 Ft. from W. Line

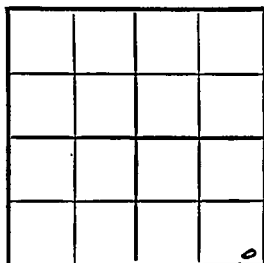

Stafford County

RECORD

Location

Cased in., ft.

Rig up

Sand

Drilling and Remarks:

Gas

Oil

Total Depth 4045

PRODUCTION

1st 24 hrs. Nat.

1st 24 hrs. after shot

Gas Cu. Ft.

Dry Hole

Abandoned

Date

OCT 13 1948

19

S. J. LEWIS

Scout