


Section 15 Township 23 Range 33W

Well No. #1 Holden

Company Ben Brack

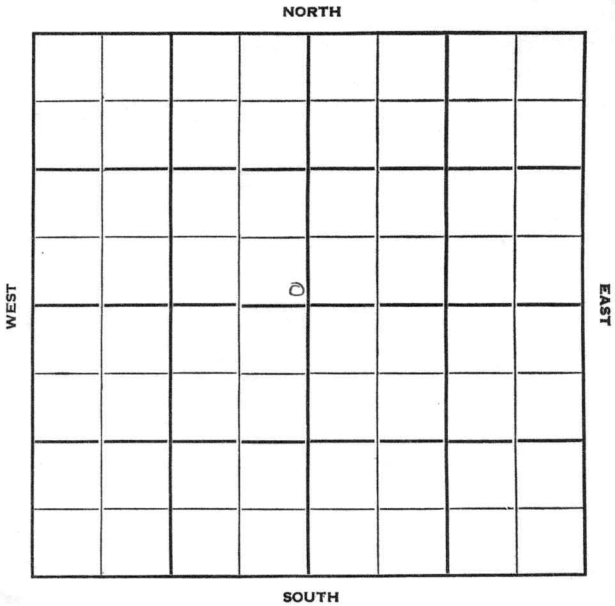

Finney

KANSAS 33W

Sec. 15 Twp. 23 R. 33W

Well No. #1 Holden Farm

Ben Brack Company

Contractor

Ft. from N. Line

150'


Ft. from S. Line

150'

Ft. from E. Line

Ft. from W. Line

SE NW

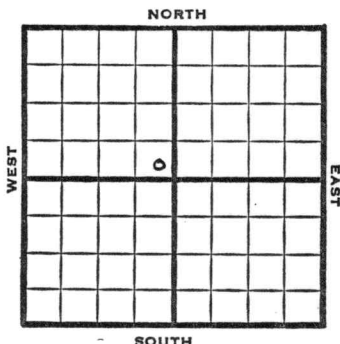

1951

Elev. 2886' REPORT

9/12

Spud 8-21-51
8" @ 348
Drlg. 2380'

1952

2/6

TD 2756' 5" @ 2720

2/13

No report

2/20

"

3/5

CO to 2756 1000 A S/load wtr
PB 2705 48/2678-90 1000 A

3/12

Sq off 124/3599-2627 114/2536-72
24/2636-72 SS gas

3/19

11,000 A

3/26

Spud 8-21-51
Gas well TD 2756' 8" @ 348
Her 2536' Kri 2560' Win. 2601'
Town. 2660' Ft. Riley 2719'
TD 2756' 5" @ 2720 CO to 2756
1000 A S/load water PB 2705'
48/2678-90 1000 A 124/2599-2627
114/2536-72 24/2536-72 11,000 A
Comp. 2,190,000 gas

COMPLETED

County **Finney** State **Kansas**Sec. **15** (Blk. Twp.) **23** (Sur. Rge.) **33W** Map No.Operator **Ben Braack**Well No. **1** Farm **Holden**Elev. Location **SE NW**

FIRST REPORT

150 Ft. From **S** Line **NW**150 Ft. From **E** Line Quarter1st. Report **SEP 1 2 1951**

Completion


Remarks

Spudding Date **8-21-51**

Drlg. Data

8" @ 348 Drlg. 2380

J. E. TYRA

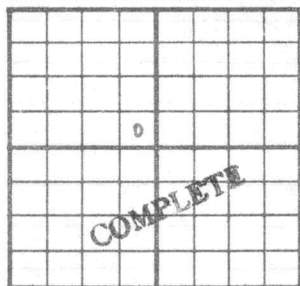County Finney State KansasSec. 15 (Blk. Twp.) 23 (Sur. Rge.) 33W Map No. _____Operator Ben BrackWell No. 1 Farm HoldenElev. 2886 Location SE NW150 Ft. From S Line NW150 Ft. From E Line Quarter1st. ReportCompletion MAR 26 1952RemarksSpudding Date 8-21-51Drlg. Data Gas well TD 27568" @ 348 Her. 2536 Kri. 2560Win. 2601 Town. 2660 Ft. Riley 2719TD 2756 5" @ 2720 CO to 2756 1000 AS/ load water PB 2705 48/ 2678-901000 A 124/ 2599-2627 114/ 2536-7224/ 2536-72 11000 AComp. 2,190,000 gas

J. G. McGEHEE