


Section 15 Township 23 Range 34W

Well No. #1 Baker

Company Champlin Ref.

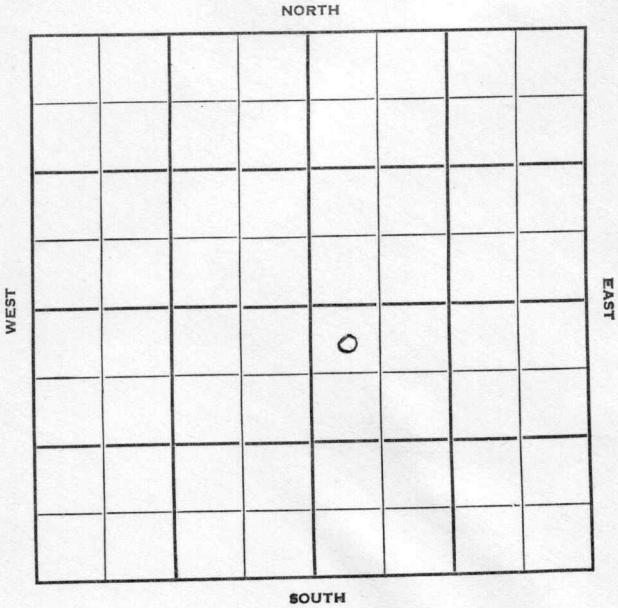

KANSAS

Finney

Sec. 15 Twp. 23 R. 34W ✓

Well No. #1 Baker Farm

Champlin Ref.

Company

Contractor


330' Ft. from N. Line

_____ Ft. from S. Line

_____ Ft. from E. Line

330' Ft. from W. Line

NW NW SE

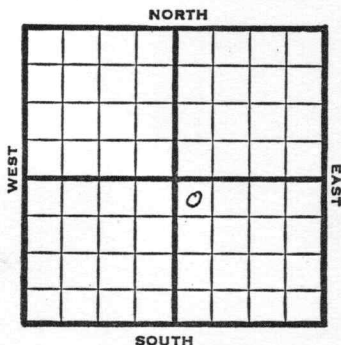

1950

Elev 2943

REPORT

6/14

Location

8/16

10" @ 593

7" @ 2647

TD 2647

18/2618-21 30/2604-09 30/2579-84

30/2536-41 18/2524-27

Her 2431

Krider 2459

Win 2522

Ft Riley 2579

78/2498-81 66/2360-71 36/2433-39

23000 total aicd Comp 720,000 gas

Completed

COMPLETED

Kansas

Map No. _____ Sec. 15 Twp. 23 R. 34WWell No. 1 Baker

Champlin Ref. _____ Company _____

Contractor _____

NW NW SE

SECTION PLAT

		0	

330 Ft. from N. Line

_____ Ft. from S. Line

_____ Ft. from E. Line

330 Ft. from W. Line

Finney County

Location X

Rig up _____

Drilling and Remarks:

RECORD

Cased _____ in., _____ ft.

Sand _____

Gas _____

Oil _____

Total Depth _____

PRODUCTION

1st 24 hrs. Nat. _____

1st 24 hrs. after shot _____

Gas _____ Cu. Ft.

Dry Hole _____

Abandoned _____

Date

JUN 14 1950 19J. E. TYRA Scout

County Finney State KansasSec. 15 (Blk.
Twp.) 23 (Sur.
Rge.) 34W Map No.Operator Champlin Ref.Well No. 1 Farm BakerElev. 2943 Location NW NW SE

330 Ft. From N Line SE330 Ft. From W Line Quarter

1st. Report

Completion AUG 16 1950

Remarks

Spudding Date

Drlg. Data Gas well TD 264710" @ 593 7" @ 2647 TD264718/ 2618-21 30/ 2604-09 30/ 2579-8430/ 2536-41 18/ 2524-27 Her. 2431Krider 2459 Win. 2522 Ft. Riley 257978/ 2498-81 66/ 2460-71 36/ 2433-3923000 total acid Comp. 720,000 gas

J. E. TYRA